

STREET

TELEMON

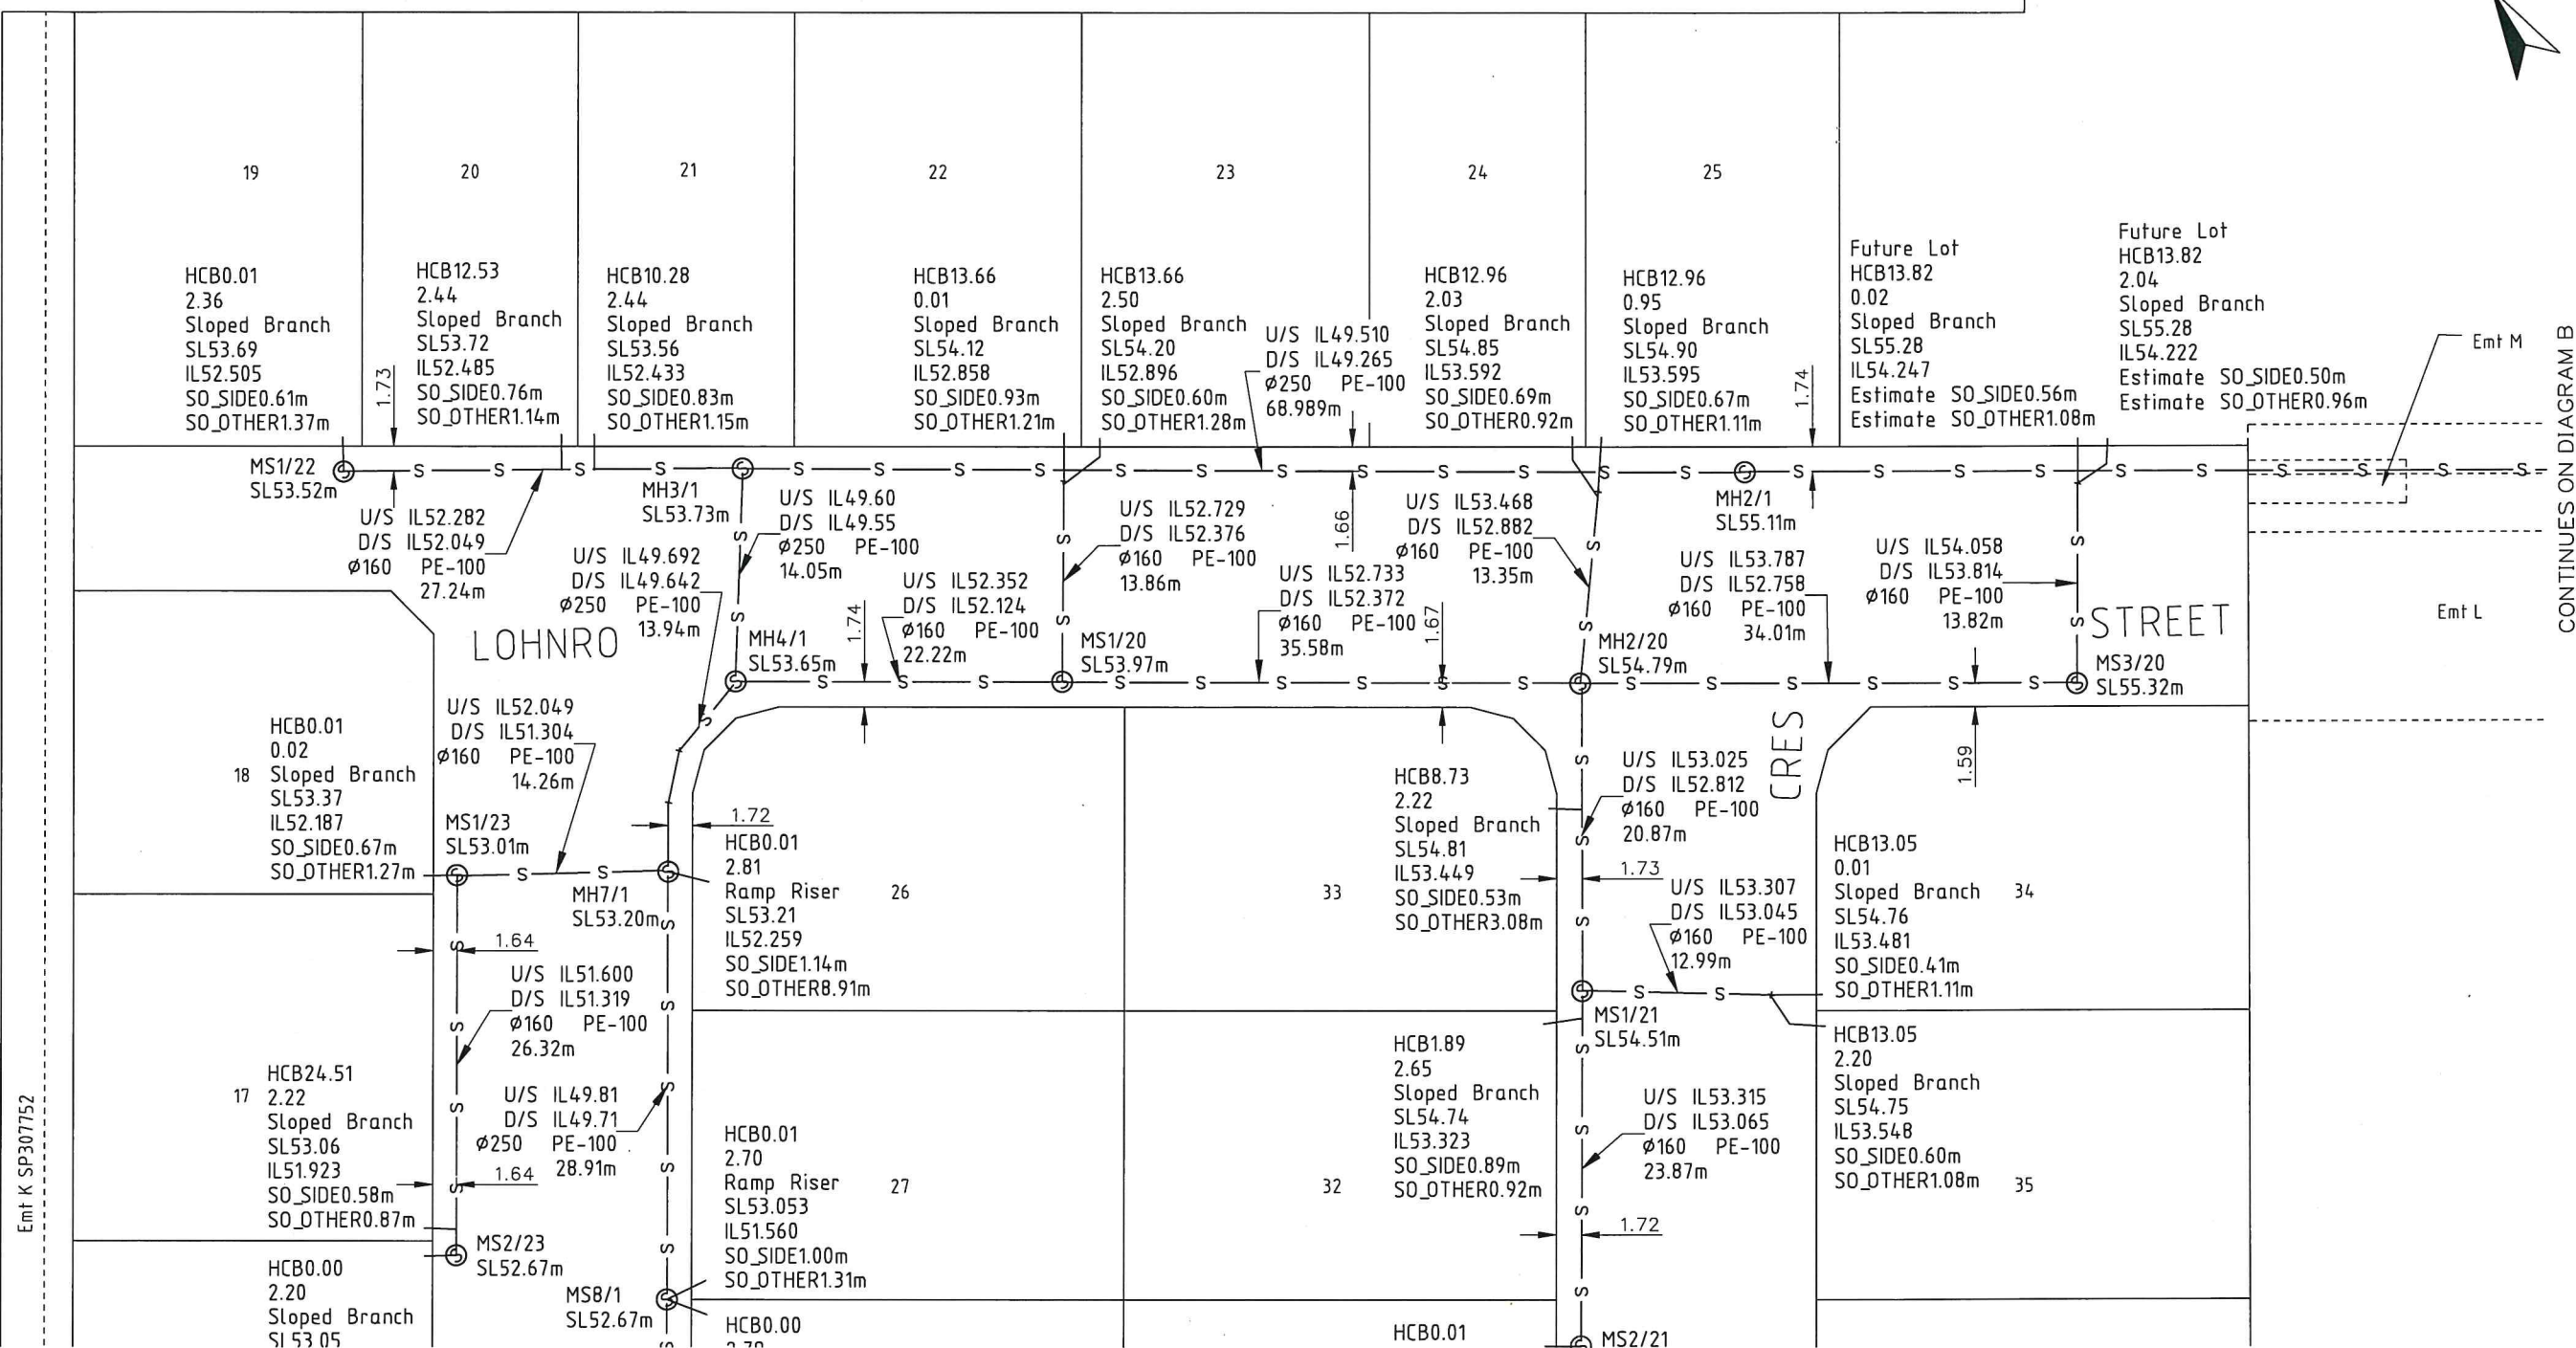


DIAGRAM A

CONTINUES ON SHEET 3

ENGINEER'S CERTIFICATION

- I, _____, hereby certify that:
- The information contained in this drawing / document is in compliance with approved drawings and design.
 - The new water and sewerage works defined by this drawing have been designed and constructed in accordance with the SEQ Code.
 - This represents an accurate record of as-constructed works
 - I accept responsibility for the information contained in this drawing / document.

RPEQ (signature) RPEQ No. _____ Date: _____


REGISTERED SURVEYOR'S CERTIFICATION

Errol Joseph Deller hereby certify that the vertical and horizontal locations and dimensions shown on this plan are a true and correct record and were located by survey.

Errol Joseph Deller
Registered Surveyor (sig.) Reg. Surveyor No. S2205 Date: 16.10.2020

DIAGRAM B

CONTINUES ON DIAGRAM A

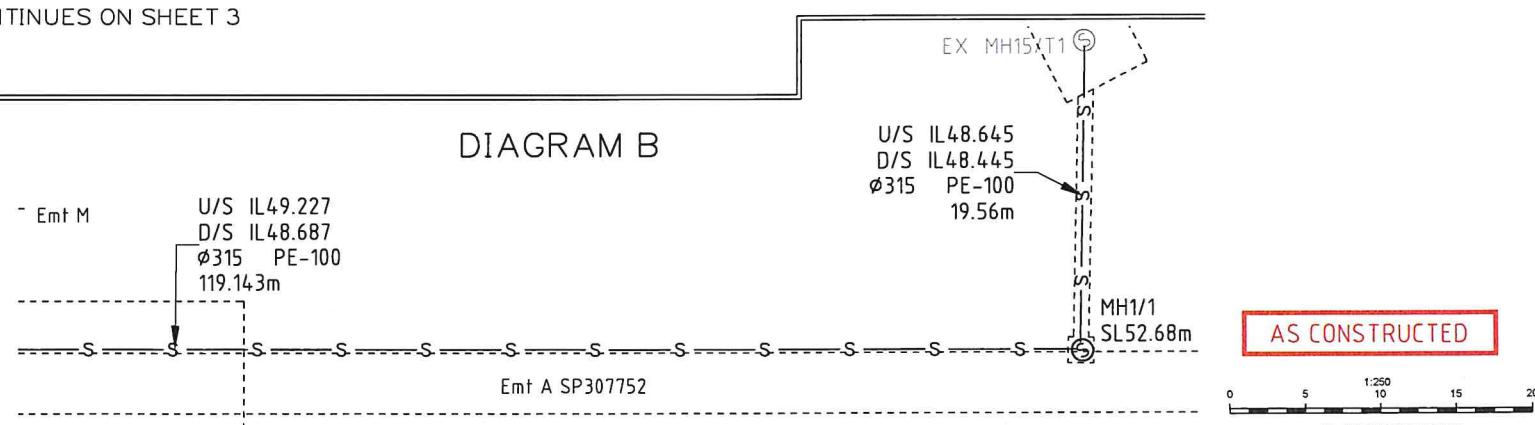

AS CONSTRUCTED

0 5 10 15 20
ALL DISTANCES IN METRES

A1

INDEX	DATE	REVISIONS	DRAWN	CHECKED	PASSED	INITIALS	DATE
3	16/10/2020	CADASTRAL UPDATED	PGC				
2	15/10/2020	DRAWING UPDATED	PGC				
1	1/10/2020	DRAWING REVISED	PGC				
0	11/9/2020	ORIGINAL ISSUE	PGC				

WD Surveys
LICENSED SURVEYORS and DEVELOPMENT CONSULTANTS
15 ANZAC AVE
REDCLIFFE 4020
P.O. Box 548
REDCLIFFE 4020
Ph: (07) 32841466
Email: mail@wdsurveys.com.au

Queensland Urban Utilities

Queensland Urban Utilities

STAGES 1A & 1B 22A TELEMON STREET, BEAUDESERT
SEWERAGE RETICULATION

SHEET 2 OF 5


SCALE 1:250

SHEET 2 OF 5 SHEETS

DRAWING NO.

AC14546S-3

CONTINUES ON SHEET 3

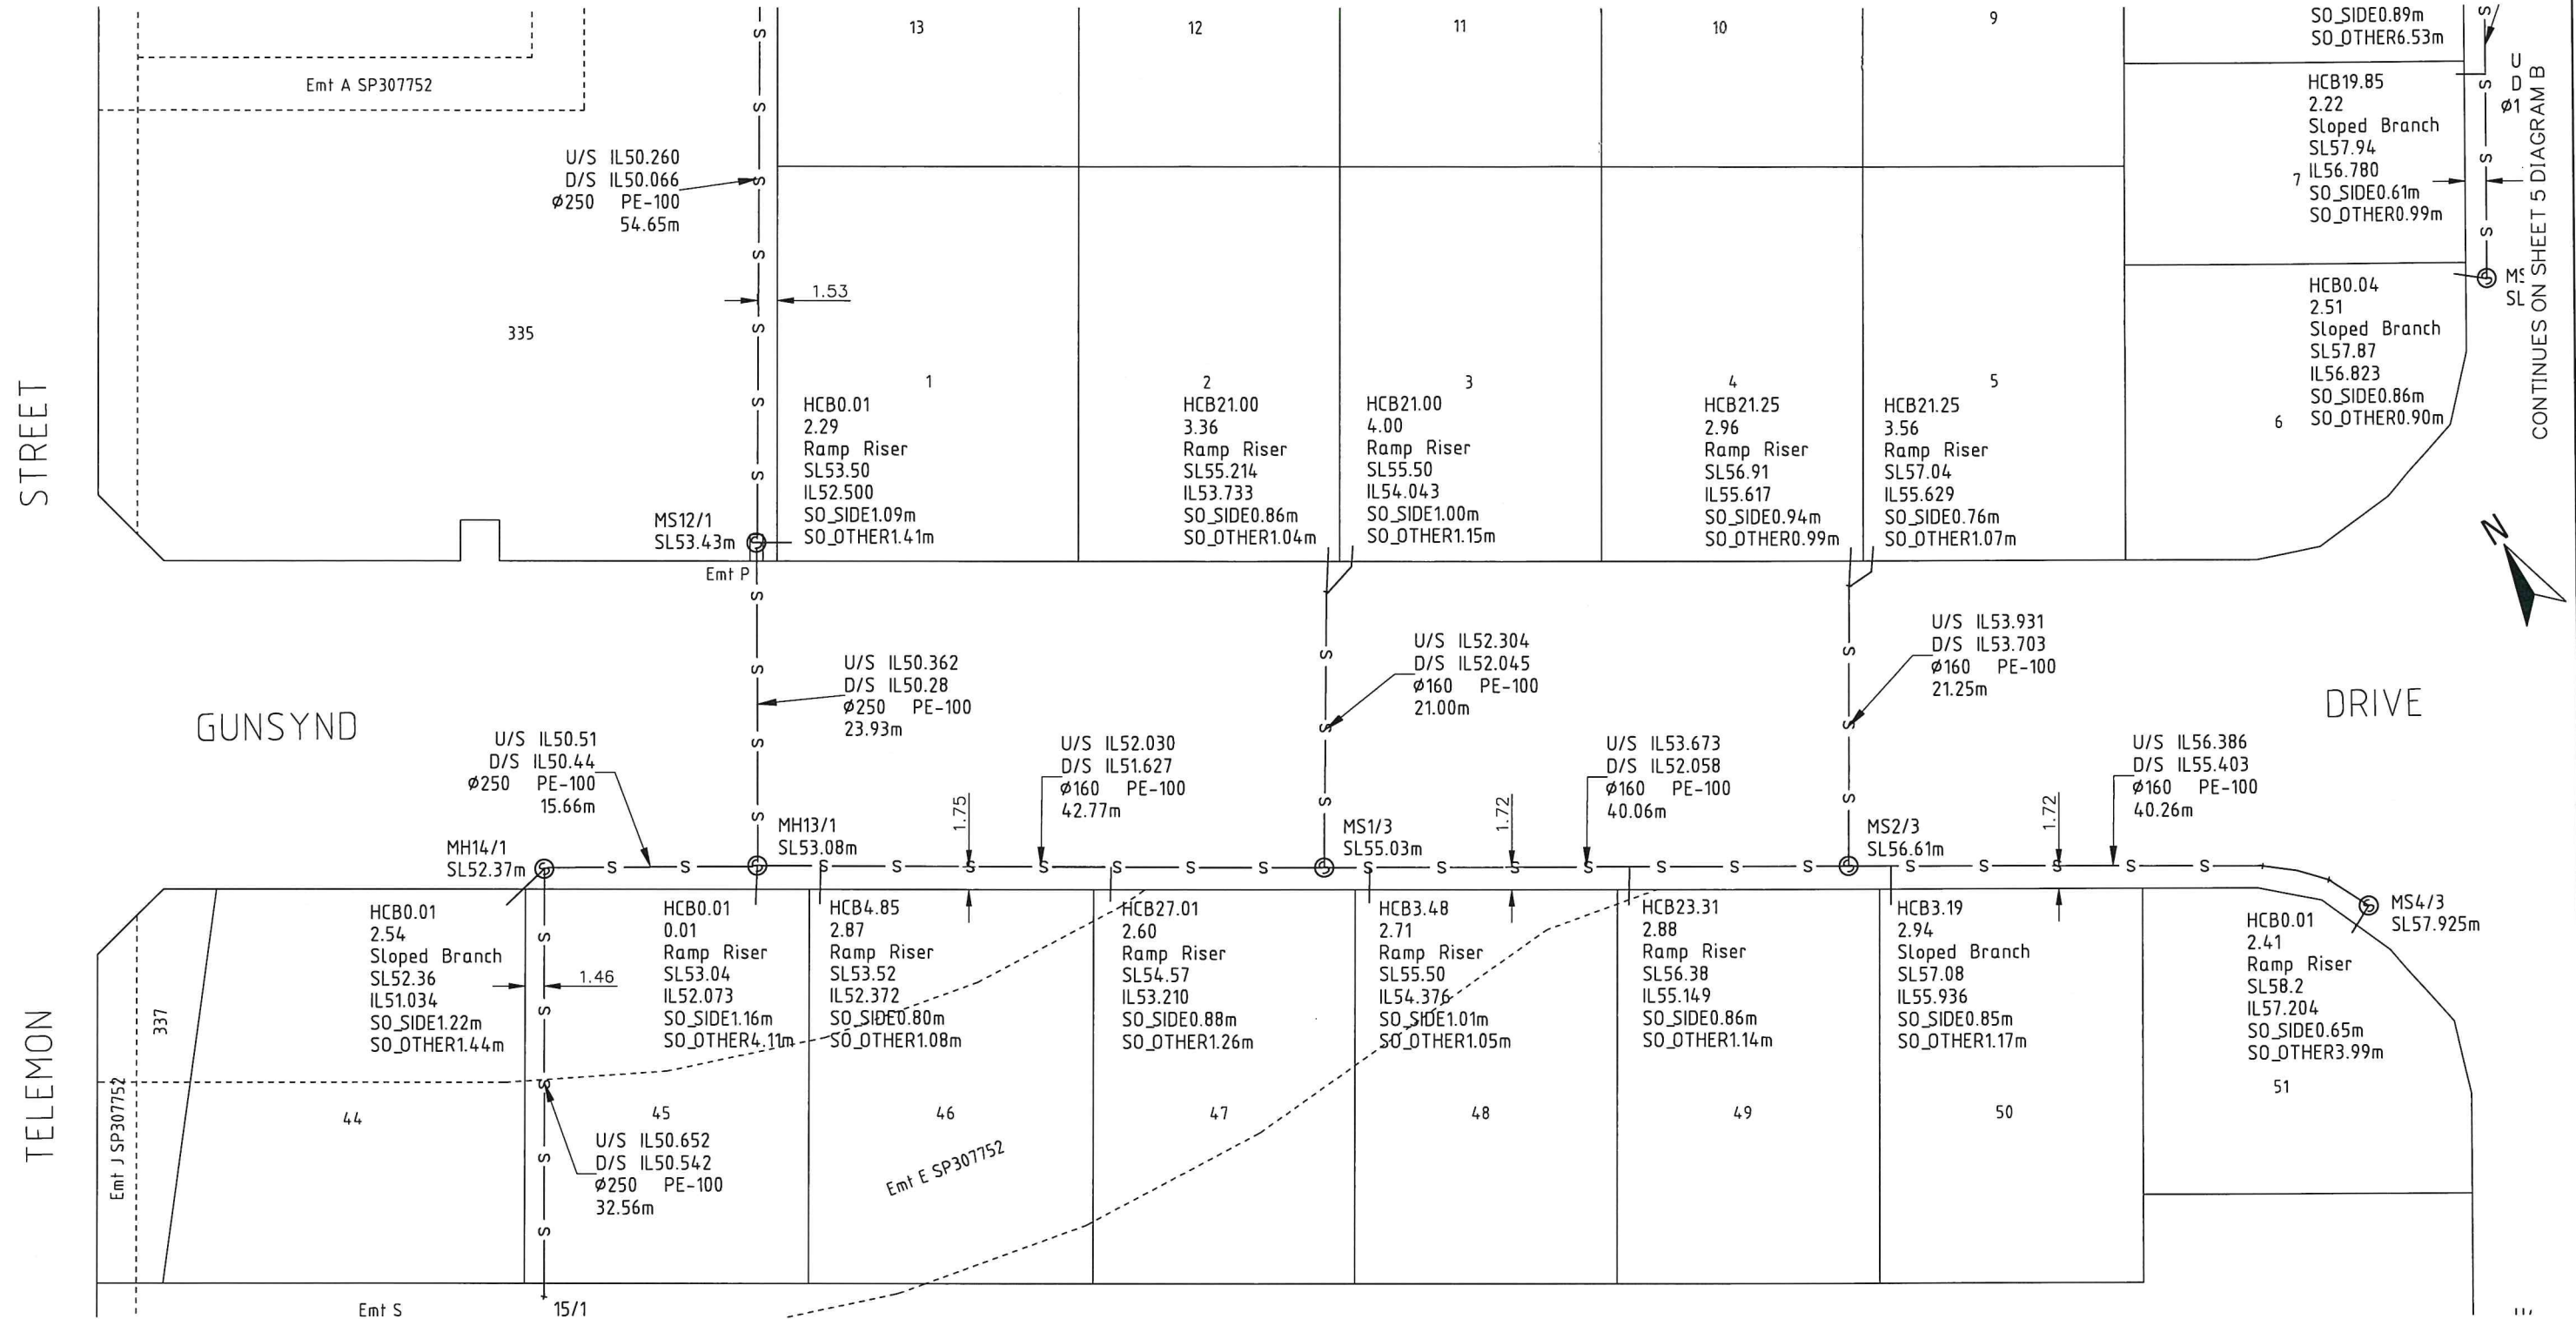

ENGINEER'S CERTIFICATION

- I, _____, hereby certify that:
- The information contained in this drawing / document is in compliance with approved drawings and design.
 - The new water and sewerage works defined by this drawing have been designed and constructed in accordance with the SEQ Code.
 - This represents an accurate record of as-constructed works
 - I accept responsibility for the information contained in this drawing / document.


RPEQ (signature) RPEQ No. _____ Date: _____

REGISTERED SURVEYOR'S CERTIFICATION

I, Errol Joseph Deller, hereby certify that the vertical and horizontal locations and dimensions shown on this plan are a true and correct record and were located by survey.

Registered Surveyor (sig.) [Signature] Reg. Surveyor No. 52205 Date: 16.10.2020

AS CONSTRUCTED

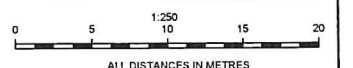

A1

INDEX	DATE	REVISIONS	DRAWN	CHECKED	PASSED
3	16/10/2020	CADASTRAL UPDATED	PGC		
2	15/10/2020	DRAWING UPDATED	PGC		
1	11/10/2020	DRAWING REVISED	PGC		
0	11/9/2020	ORIGINAL ISSUE	PGC		

DRAWN	PGC	11-9-2020
CHECKED		
PASSED		
INITIALS	DATE	

WD Surveys
 15 ANZAC AVE
 REDCLIFFE 4020
 P.O. Box 548
 REDCLIFFE 4020
 Ph: (07) 32841466
 Email: mail@wdsurveys.com.au

Queensland Urban Utilities

Queensland Urban Utilities

STAGES 1A & 1B 22A TELEMON STREET, BEAUDESERT
 SEWERAGE RETICULATION

SHEET 4 OF 5

SCALE	1:250
SHEET 4 OF 5 SHEETS	
DRAWING NO.	AC14546S-3

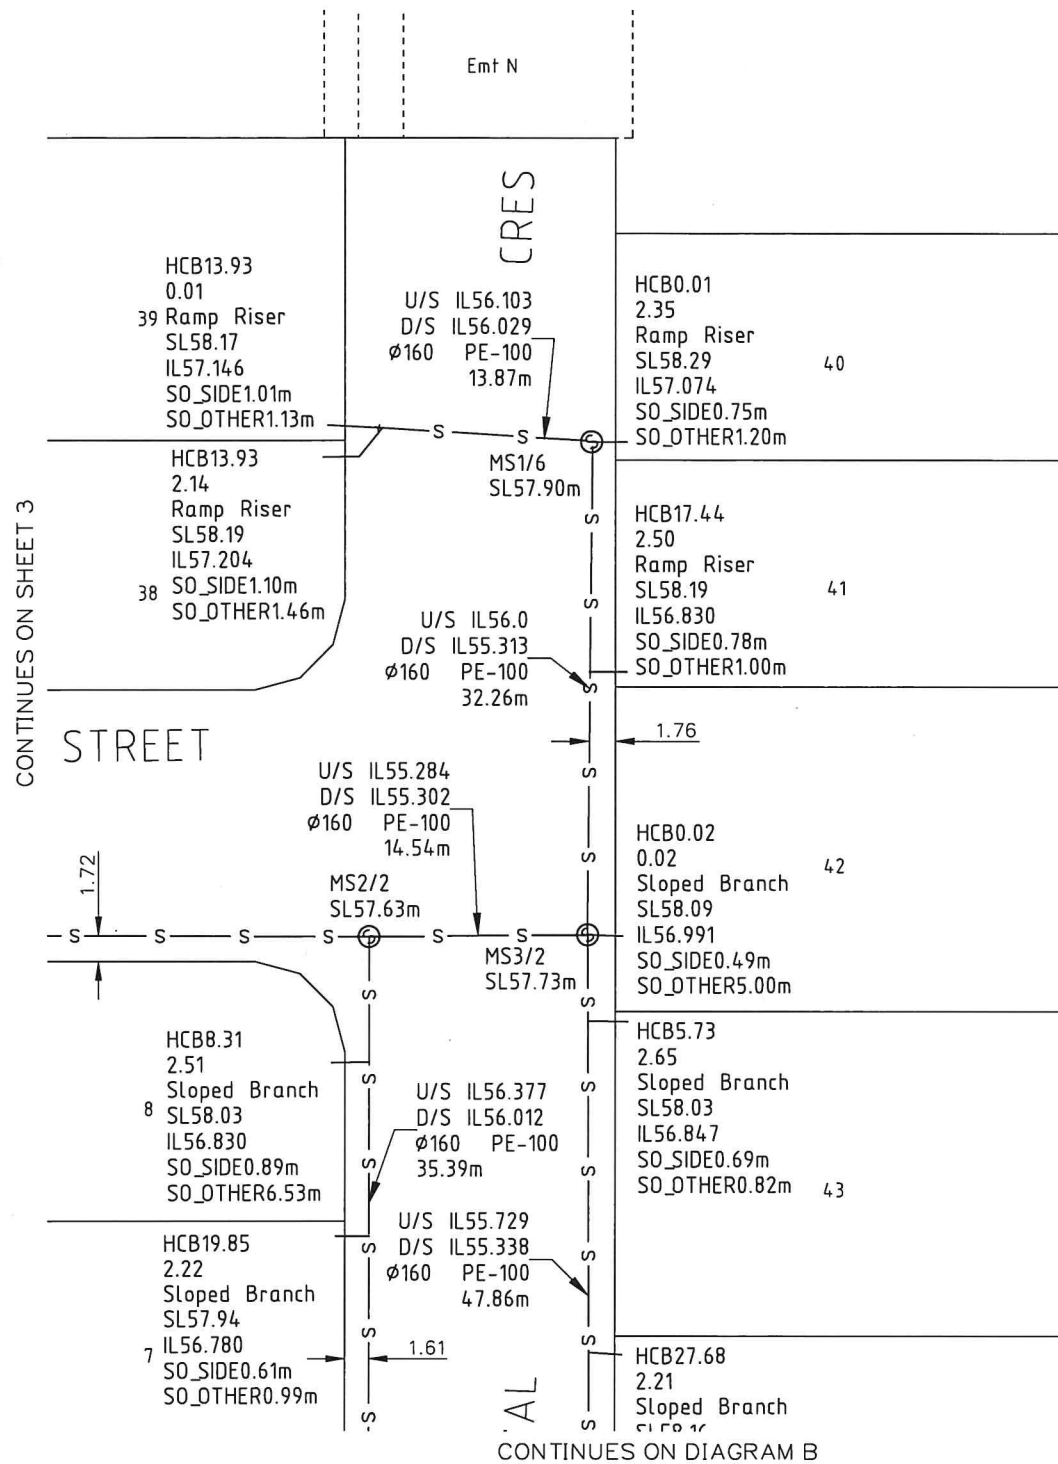


DIAGRAM A

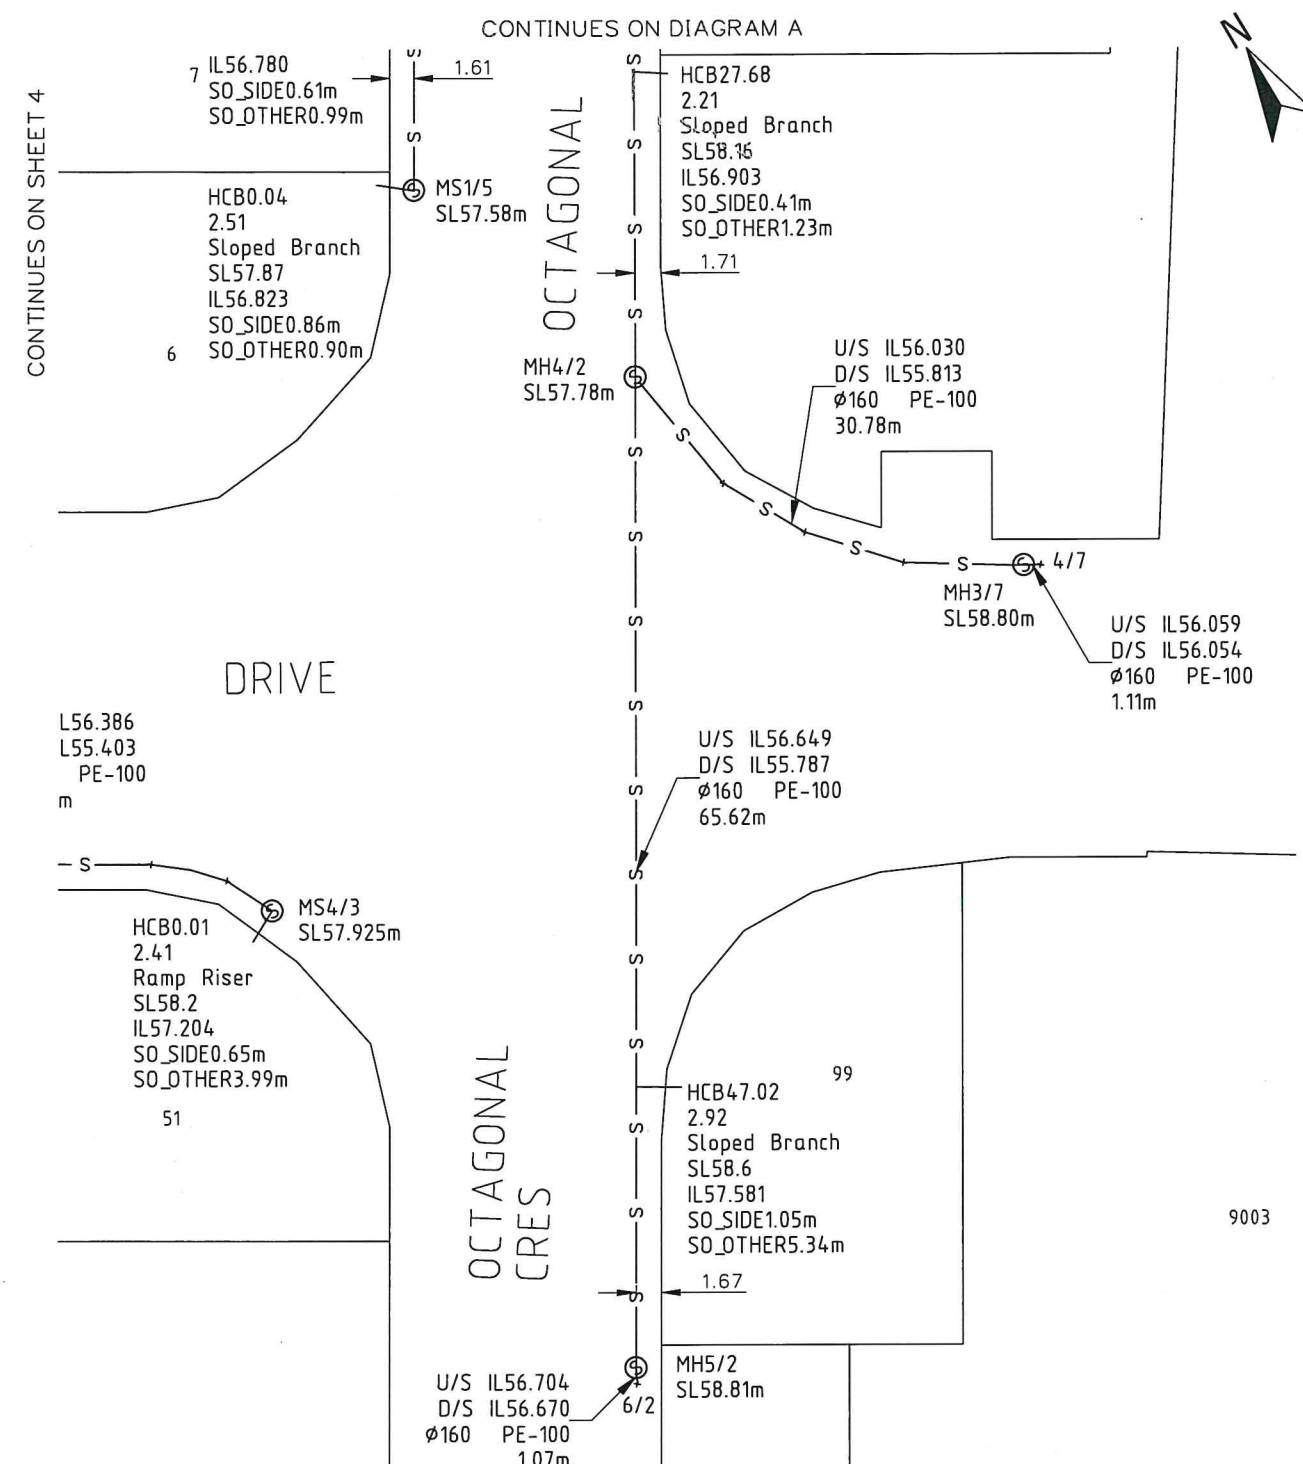


DIAGRAM B

ENGINEER'S CERTIFICATION

- I, _____, hereby certify that:
- The information contained in this drawing / document is in compliance with approved drawings and design.
 - The new water and sewerage works defined by this drawing have been designed and constructed in accordance with the SEQ Code.
 - This represents an accurate record of as-constructed works.
 - I accept responsibility for the information contained in this drawing / document.


RPEQ (signature) RPEQ No. _____ Date: _____

REGISTERED SURVEYOR'S CERTIFICATION

Erol Joseph Jeller hereby certify that the vertical and horizontal locations and dimensions shown on this plan are a true and correct record and were located by survey.

[Signature]
Registered Surveyor (sig.) Reg. Surveyor No. 52205 Date: 16.10.2020

AS CONSTRUCTED

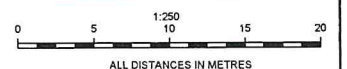

A1

INDEX	DATE	REVISIONS	DRAWN	CHECKED	PASSED
3	16/10/2020	CADASTRAL UPDATED	PGC		
2	15/10/2020	DRAWING UPDATED	PGC		
1	7/10/2020	DRAWING REVISED	PGC		
0	11/9/2020	ORIGINAL ISSUE	PGC		

DRAWN	PGC	11-9-2020
CHECKED		
PASSED		
INITIALS	DATE	

WD Surveys
LICENSED SURVEYORS and DEVELOPMENT CONSULTANTS
15 ANZAC AVE
REDCLIFFE 4020
P.O. Box 548
REDCLIFFE 4020
Ph: (07) 32841466
Email: mail@wdsurveys.com.au



Queensland Urban Utilities

STAGES 1A & 1B 22A TELEMONT STREET, BEAUDESERT
SEWERAGE RETICULATION

SHEET 5 OF 5

SCALE	1:250
SHEET 5 OF 5 SHEETS	
DRAWING NO.	AC14546S-3