



REGISTERED SURVEYOR'S CERTIFICATION

I, Errol Joseph Deller, hereby certify that the vertical and horizontal locations and dimensions shown on this plan are a true and correct record and were located by survey.

[Signature]
Registered Surveyor (sig.) Reg. Surveyor No. 52205 Date: 15.10.2020


ENGINEER'S CERTIFICATION

I, _____, hereby certify that:

1. The information contained in this drawing / document is in compliance with approved drawings and design.
2. The new water and sewerage works defined by this drawing have been designed and constructed in accordance with the SEQ Code.
3. This represents an accurate record of as-constructed works
4. I accept responsibility for the information contained in this drawing / document.

RPEQ (signature) RPEQ No. _____ Date: _____

AS CONSTRUCTED

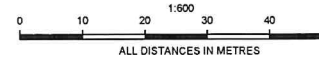

A1	2	15/10/2020	2 x GRABALLS ADDED	PGC		
	1	8/10/2020	DRAWING REVISED	PGC		
	0	22/9/2020	ORIGINAL ISSUE	PGC		
	INDEX	DATE	REVISIONS	DRAWN	CHECKED	PASSED

WD Surveys
15 ANZAC AVE
REDCLIFFE 4020
P.O. Box 548
REDCLIFFE 4020

LICENSED SURVEYORS and
DEVELOPMENT CONSULTANTS
Ph: (07) 32841466
Email: mail@wdsurveys.com.au

DRAWN	PGC	22-9-2020
CHECKED		
PASSED		
INITIALS		DATE



Queensland Urban Utilities

STAGES 1A & 1B 22A TELEMON STREET, BEAUDESERT
WATER RETICULATION - OVERALL PLAN

SHEET 1 OF 5


SCALE	1:600
SHEET 1 OF	5 SHEETS
DRAWING NO.	
AC14546W-2	
	2
	1
	0



STREET

TELEMON

9001(Pt)

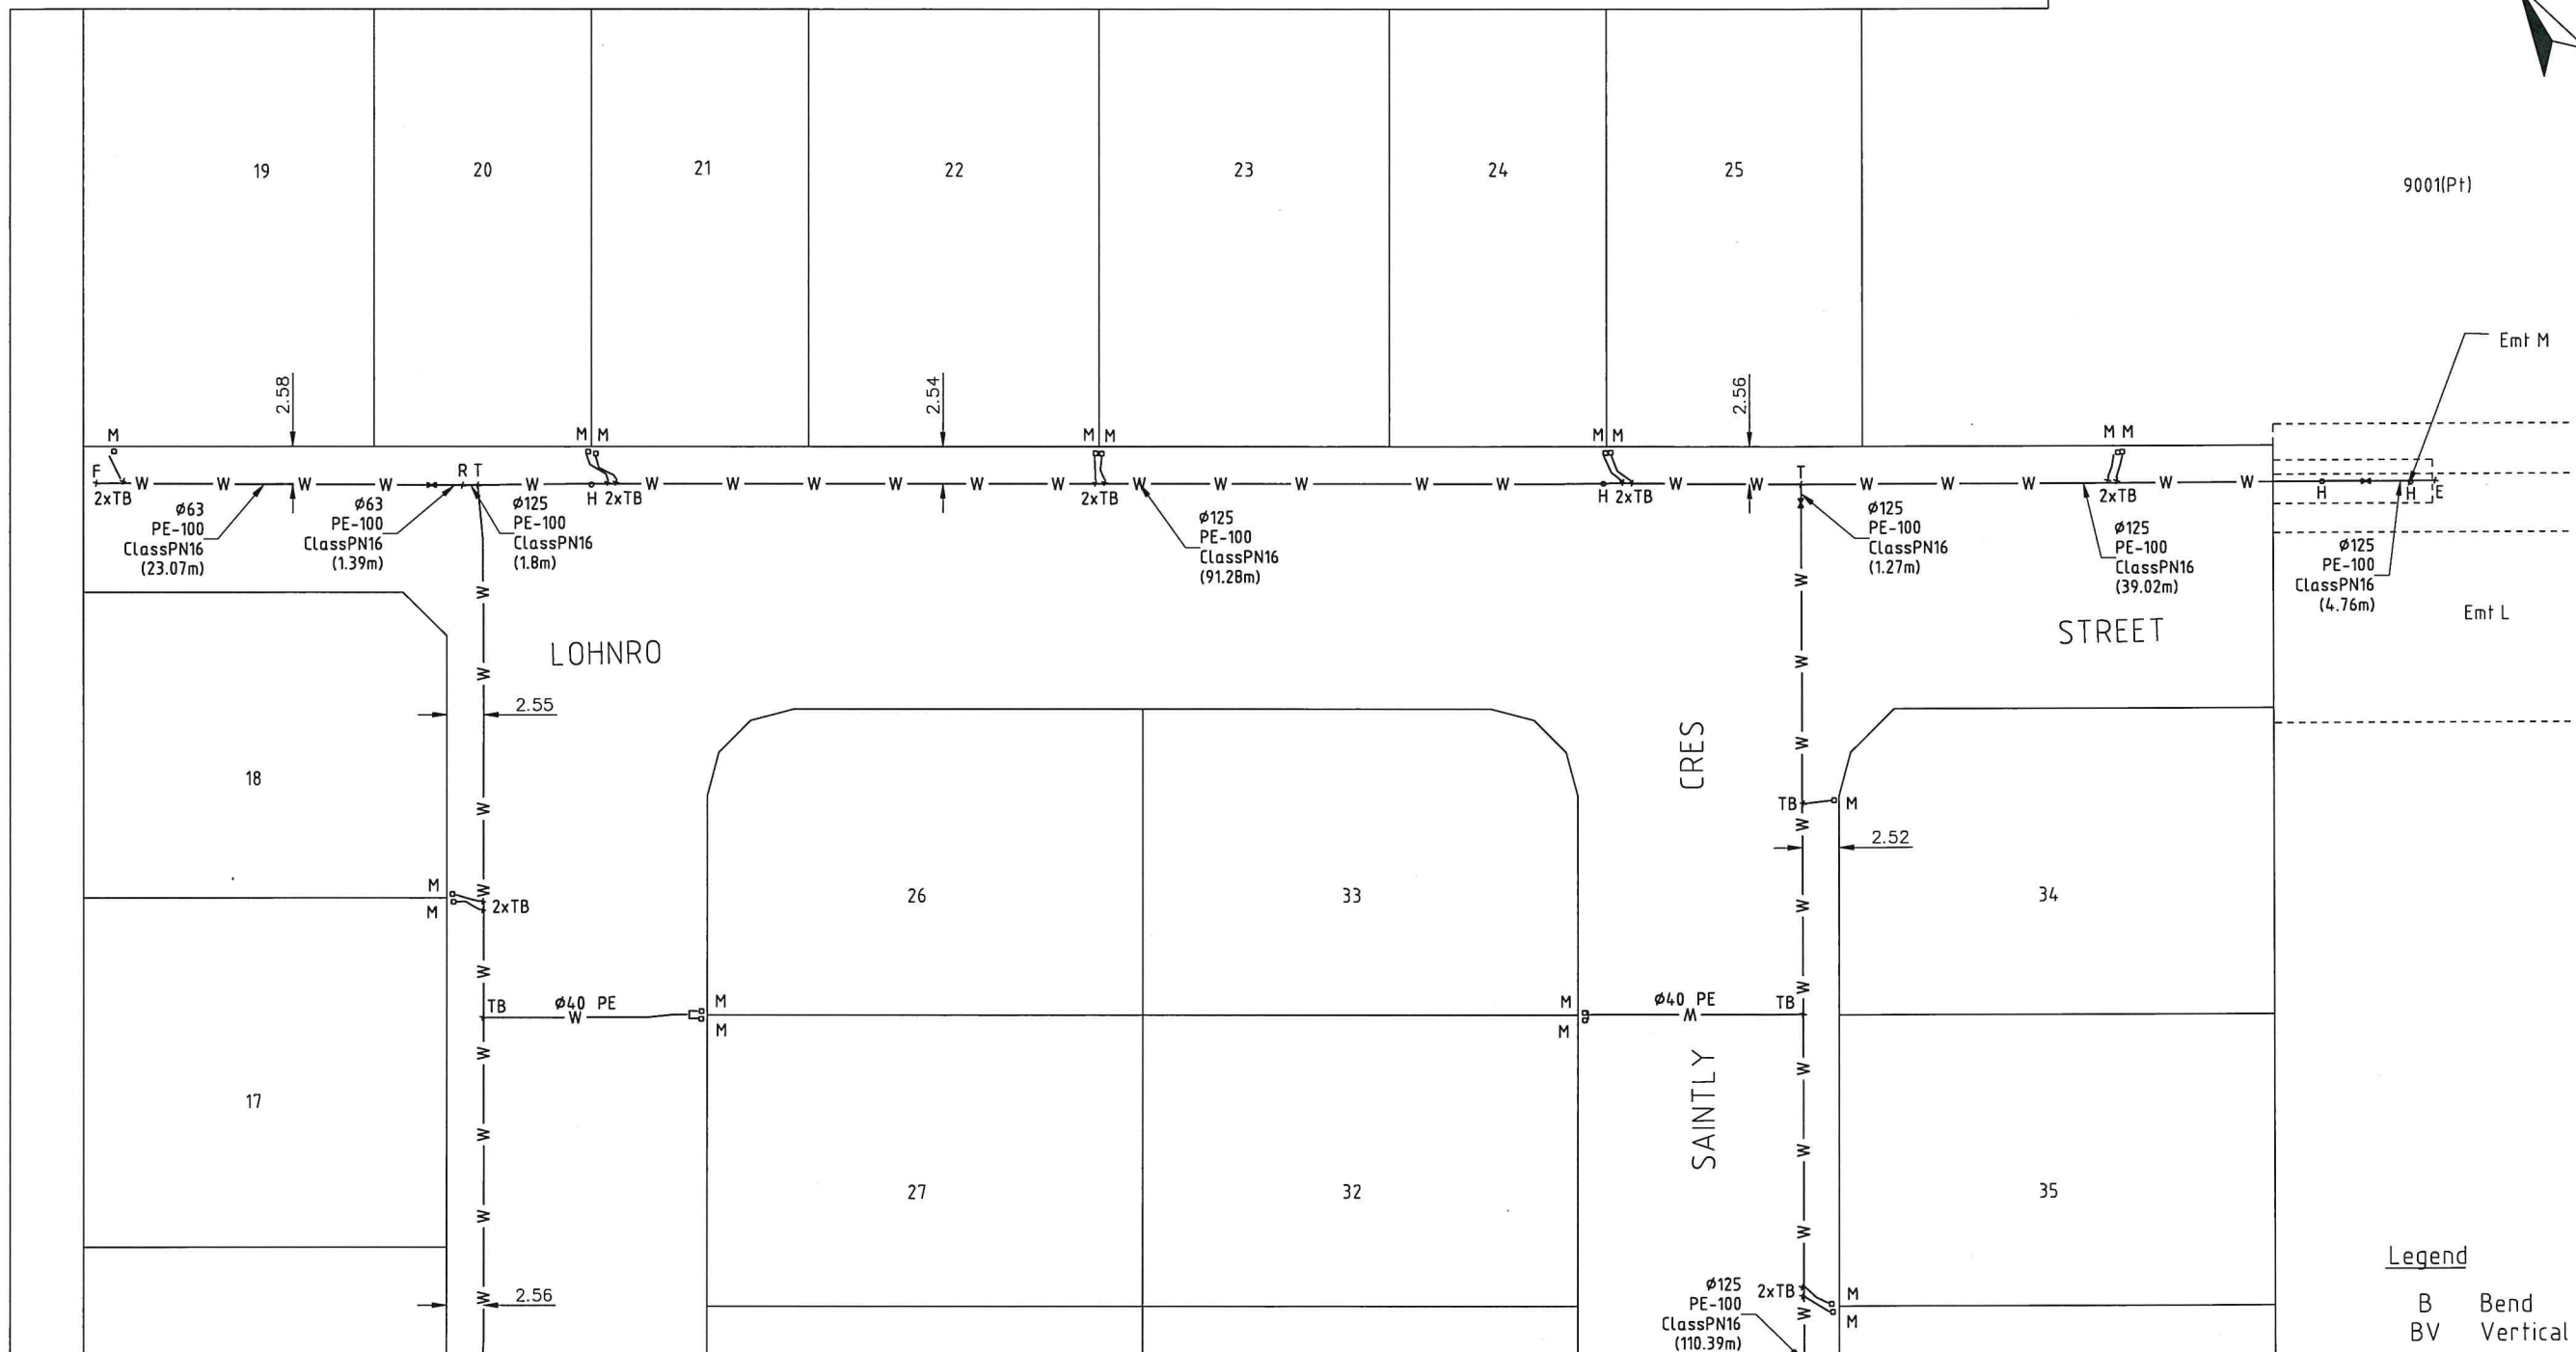

CONTINUES ON SHEET 3

Legend

- B Bend
- BV Vertical bend
- C Connector
- E Dead end
- F Flushing point
- G Gibault
- H Hydrant
- M Meter
- R Reducer/Taper
- T Tee
- TB Tapping band
- V Vertical bend

AS CONSTRUCTED



ENGINEER'S CERTIFICATION

- I, _____, hereby certify that:
- The information contained in this drawing / document is in compliance with approved drawings and design.
 - The new water and sewerage works defined by this drawing have been designed and constructed in accordance with the SEQ Code.
 - This represents an accurate record of as-constructed works
 - I accept responsibility for the information contained in this drawing / document.

RPEQ (signature) RPEQ No. _____ Date: _____

REGISTERED SURVEYOR'S CERTIFICATION

I, Errol Joseph Deller, hereby certify that the vertical and horizontal locations and dimensions shown on this plan are a true and correct record and were located by survey.

[Signature]
Registered Surveyor (sig) Reg. Surveyor No. S2205 Date: 15.10.2020

A1

INDEX	DATE	REVISIONS	DRAWN	CHECKED	PASSED
2	15/10/2020	2 x GIBAUTS ADDED	PGC		
1	9/10/2020	DRAWING REVISED	PGC		
0	22/9/2020	ORIGINAL ISSUE	PGC		

INITIALS	DATE
DRAWN	PGC 22-9-2020
CHECKED	
PASSED	

WD Surveys
LICENSED SURVEYORS and DEVELOPMENT CONSULTANTS
15 ANZAC AVE
REDCLIFFE 4020
P.O. Box 548
REDCLIFFE 4020
Ph: (07) 32841466
Email: mail@wdsurveys.com.au




Queensland Urban Utilities

STAGES 1A & 1B 22A TELEMON STREET, BEAUDESERT
WATER RETICULATION

SHEET 2 OF 5

SCALE	1:250
SHEET 2 OF 5 SHEETS	
DRAWING NO.	AC14546W-2
	2
	1
	0

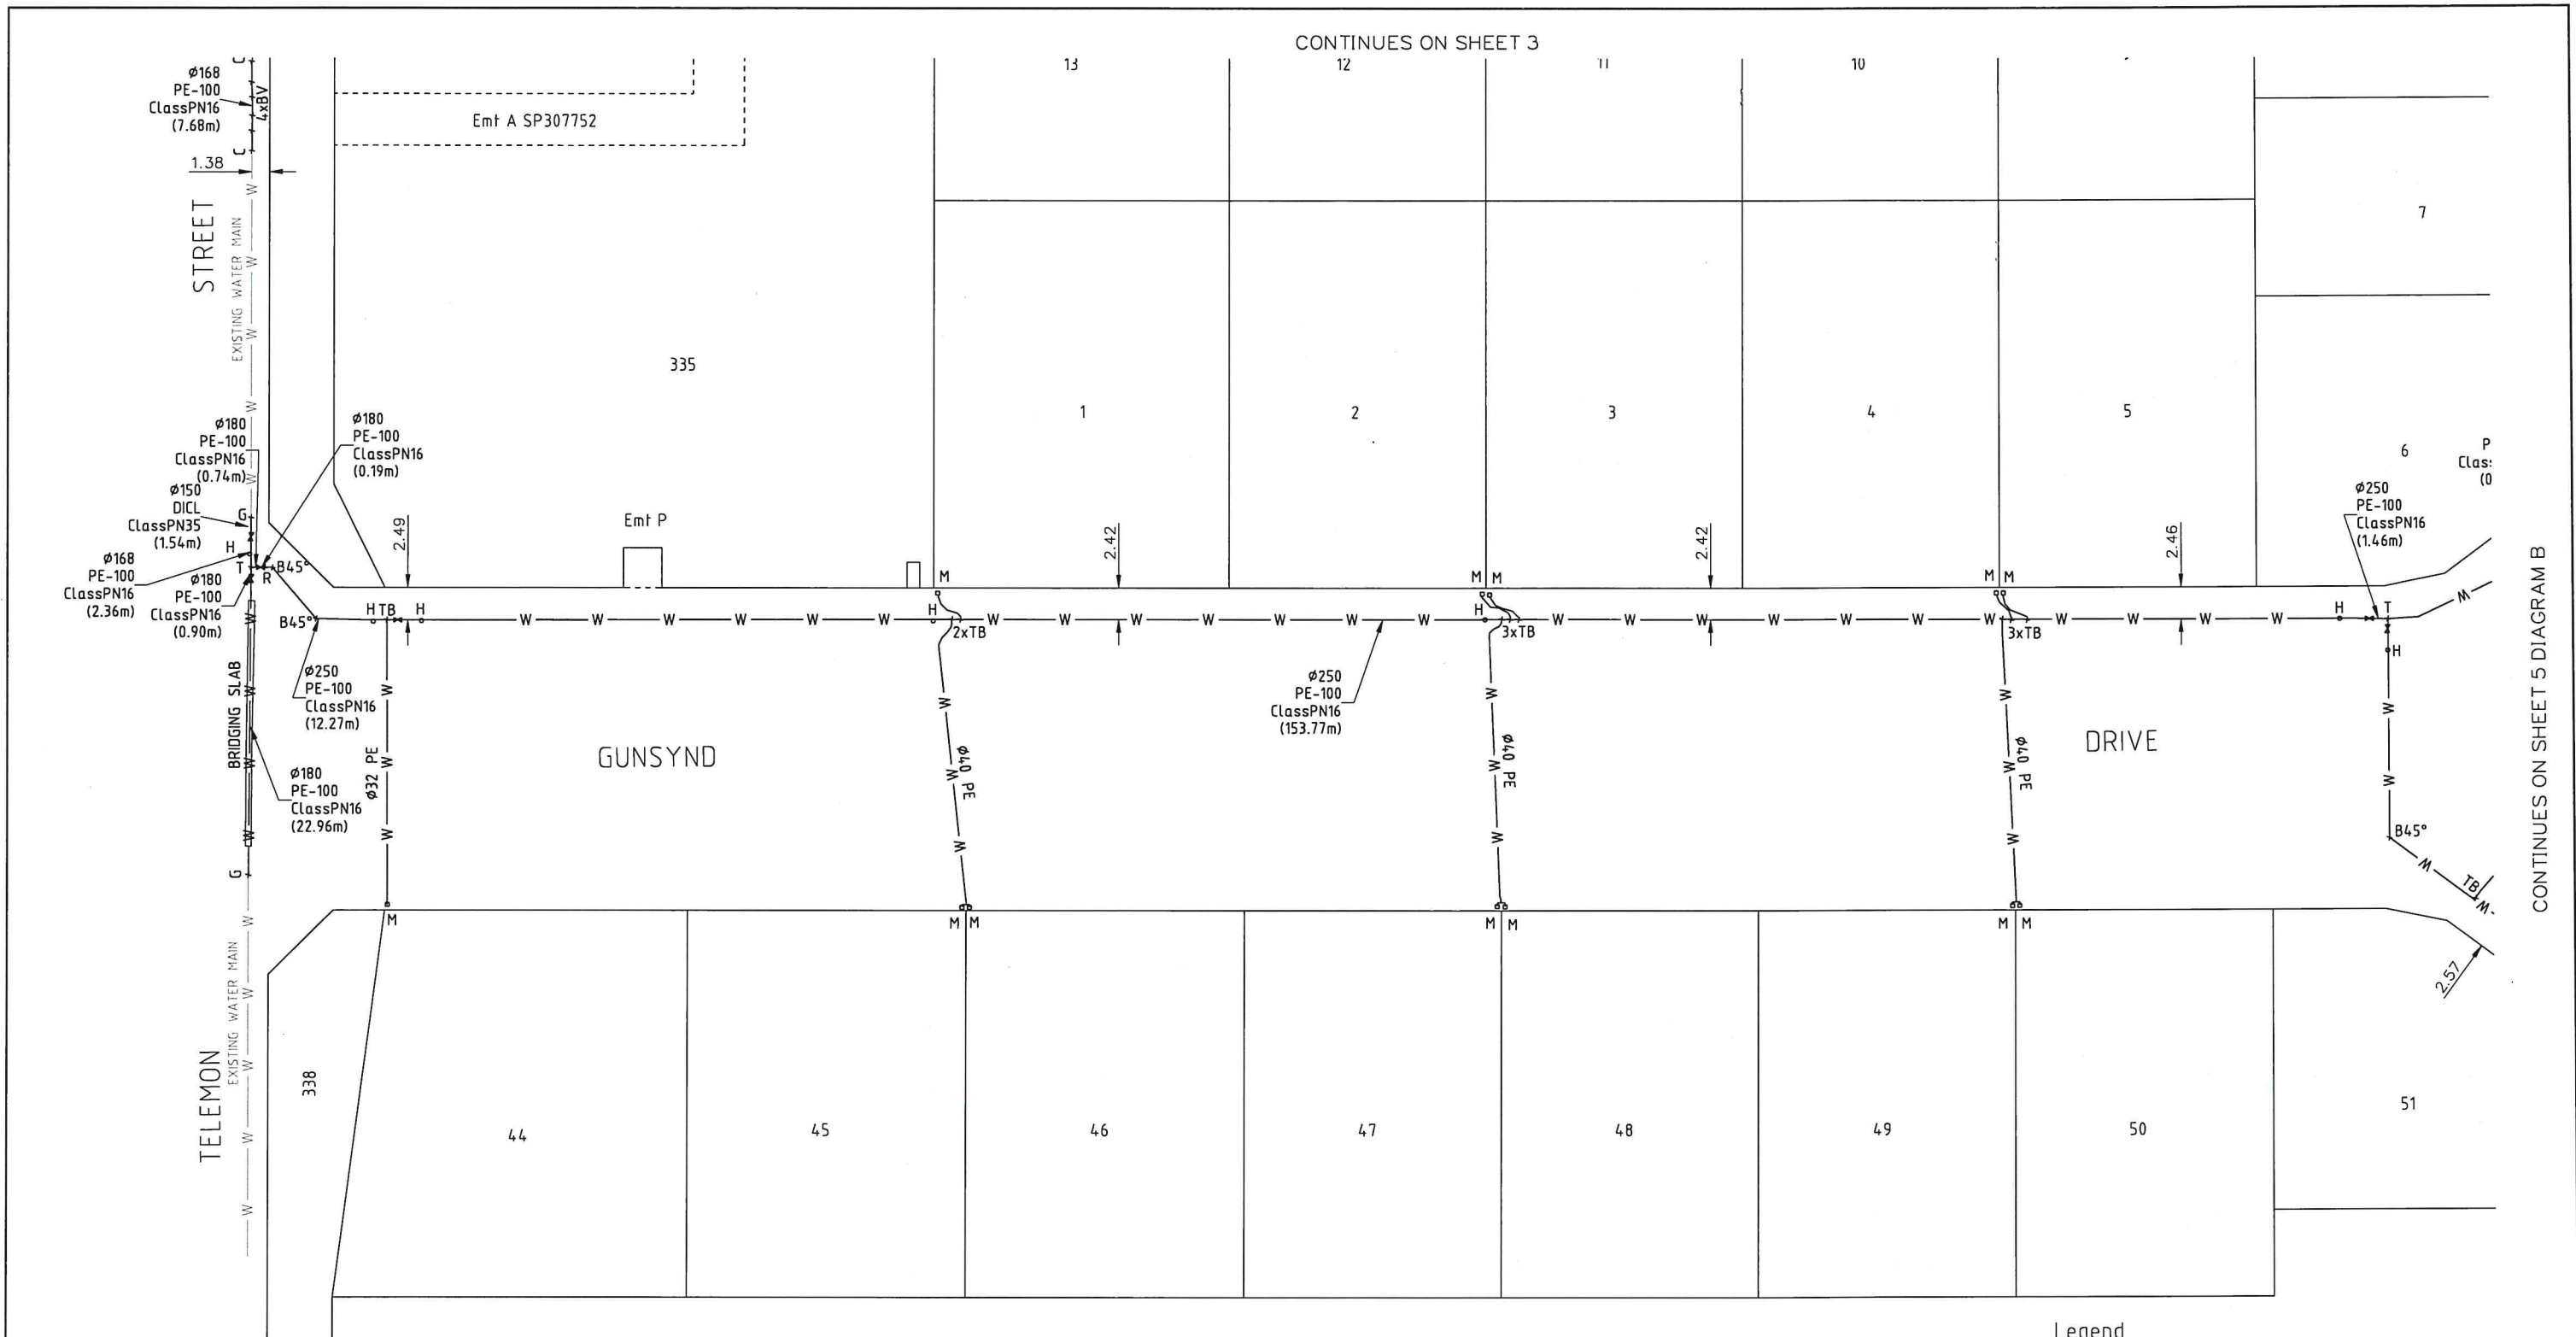

CONTINUES ON SHEET 3

CONTINUES ON SHEET 5 DIAGRAM B

ENGINEER'S CERTIFICATION

I, _____, hereby certify that:
 1. The information contained in this drawing / document is in compliance with approved drawings and design.
 2. The new water and sewerage works defined by this drawing have been designed and constructed in accordance with the SEQ Code.
 3. This represents an accurate record of as-constructed works
 4. I accept responsibility for the information contained in this drawing / document.

 RPEQ (signature) RPEQ No. _____ Date: _____

REGISTERED SURVEYOR'S CERTIFICATION

I, Erin Joseph Keller, hereby certify that the vertical and horizontal locations and dimensions shown on this plan are a true and correct record and were located by survey.


[Signature]
 Registered Surveyor (sig.) Reg. Surveyor No. 52205 Date: 15.10.2020


Legend

- B Bend
- BV Vertical bend
- C Connector
- E Dead end
- F Flushing point
- G Gibault
- H Hydrant
- M Meter
- R Reducer/Taper
- T Tee
- TB Tapping band
- V Vertical bend



AS CONSTRUCTED

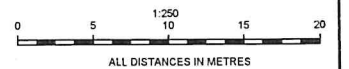

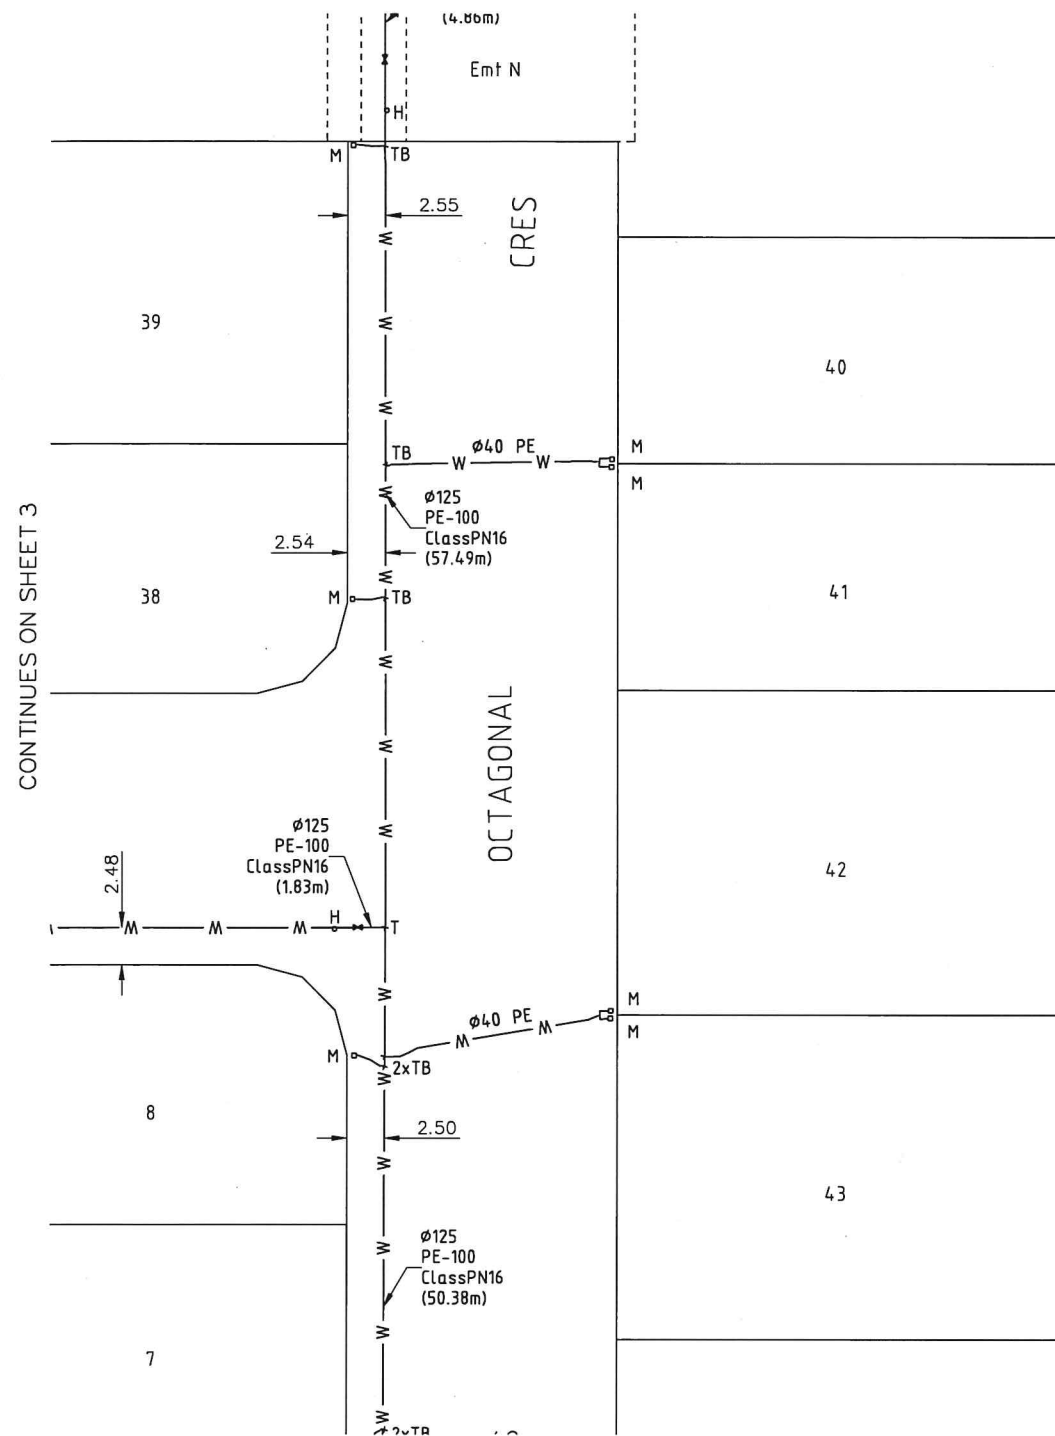

CONTINUES ON DIAGRAM B

DIAGRAM A

ENGINEER'S CERTIFICATION

- I, _____, hereby certify that:
- The information contained in this drawing / document is in compliance with approved drawings and design.
 - The new water and sewerage works defined by this drawing have been designed and constructed in accordance with the SEQ Code.
 - This represents an accurate record of as-constructed works
 - I accept responsibility for the information contained in this drawing / document.

RPEQ (signature) RPEQ No. _____ Date: _____

REGISTERED SURVEYOR'S CERTIFICATION

I, Errol Joseph Deller, hereby certify that the vertical and horizontal locations and dimensions shown on this plan are a true and correct record and were located by survey.

Registered Surveyor (sig) [Signature] Reg. Surveyor No. S2205 Date: 15.10.2020

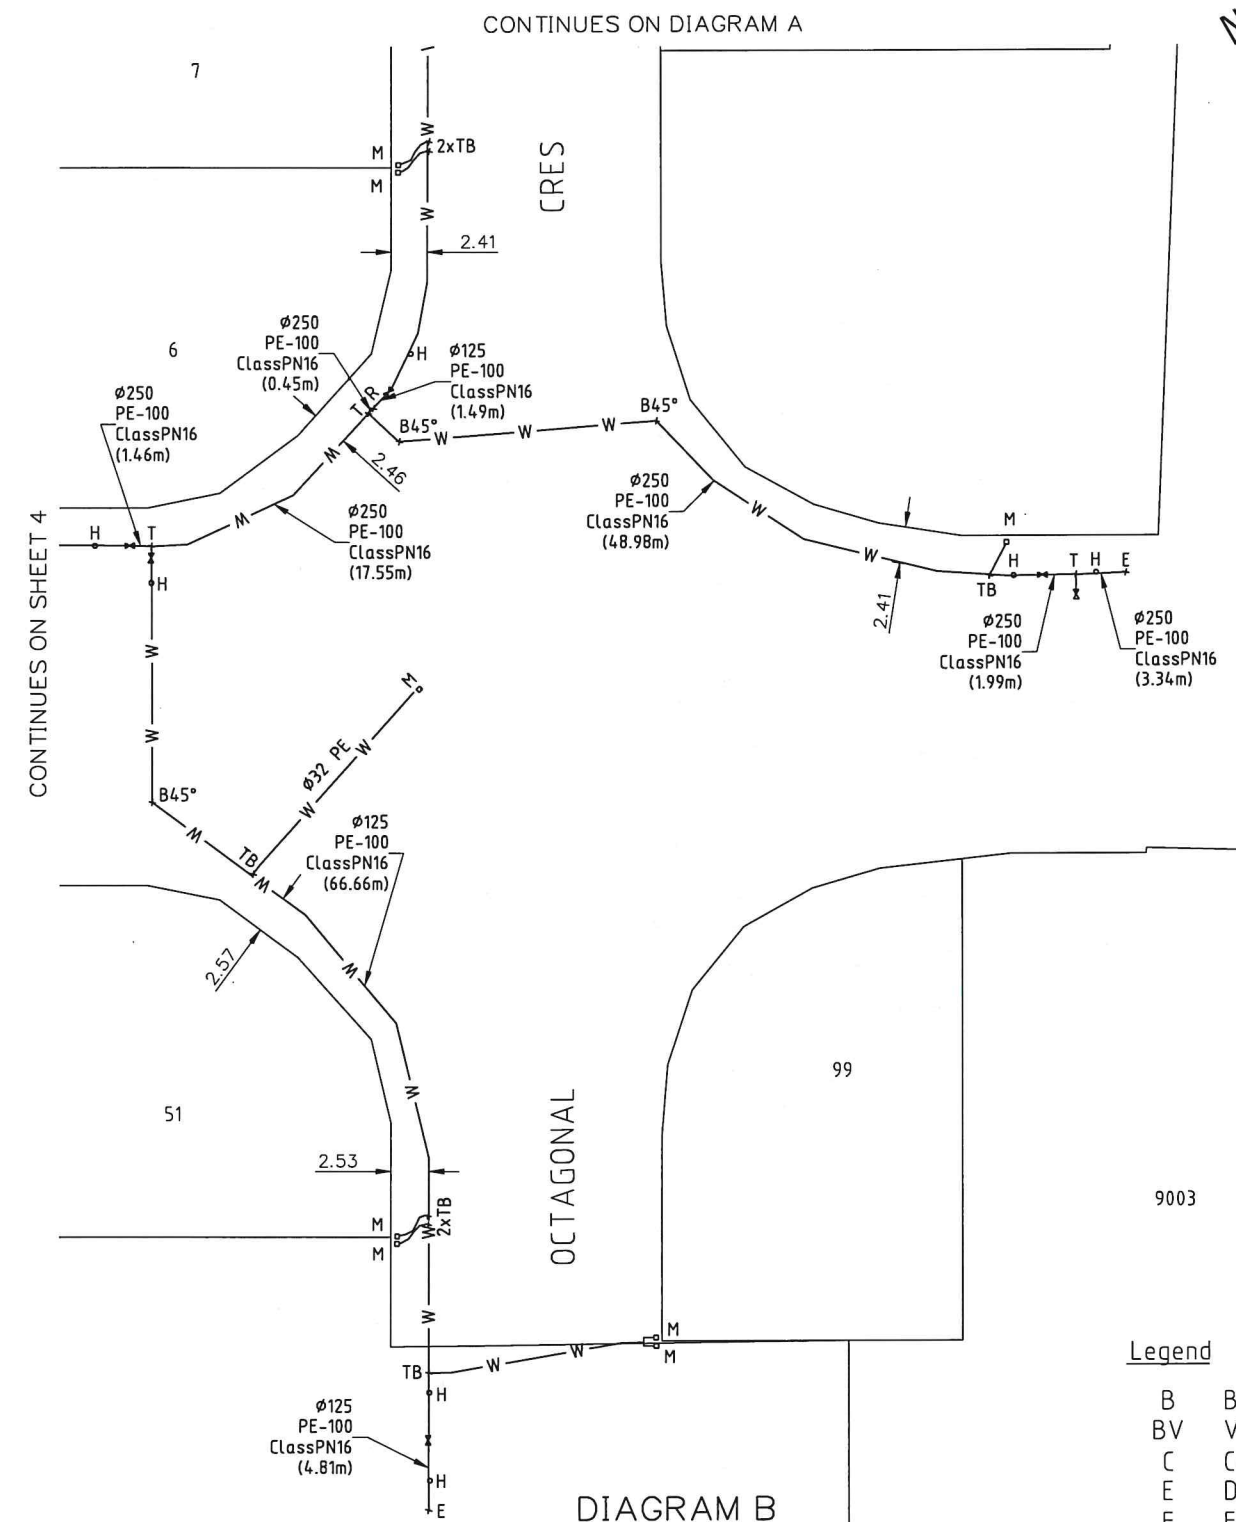


DIAGRAM B

Legend

- B Bend
- BV Vertical bend
- C Connector
- E Dead end
- F Flushing point
- G Gibault
- H Hydrant
- M Meter
- R Reducer/Taper
- T Tee
- TB Tapping band
- V Vertical bend

AS CONSTRUCTED

SCALE 1:250
SHEET 5 OF 5 SHEETS
DRAWING NO.
AC14546W-2

A1

INDEX	DATE	REVISIONS	DRAWN	CHECKED	PASSED
2	15/10/2020	2 x GIBALTS ADDED	PGC		
1	11/10/2020	DRAWING REVISED	PGC		
0	22/9/2020	ORIGINAL ISSUE	PGC		

INITIALS	DATE
DRAWN	PGC 22-9-2020
CHECKED	
PASSED	

WD Surveys
LICENSED SURVEYORS and DEVELOPMENT CONSULTANTS
15 ANZAC AVE
REDCLIFFE 4020
P.O. Box 548
REDCLIFFE 4020
Ph: (07) 32841466
Email mail@wdsurveys.com.au

Queensland Urban Utilities

Queensland Urban Utilities

STAGES 1A & 1B 22A TELEMONT STREET, BEAUCESERT
WATER RETICULATION

SHEET 5 OF 5