

A1					
	0	2-11-2020	ORIGINAL ISSUE	PGE	
	INDEX	DATE	REVISIONS	DRAWN	CHECKED

WD Surveys

LICENSED SURVEYORS and
DEVELOPMENT CONSULTANTS



15 ANZAC AVE
REDCLIFFE 4020
P.O.Box 548
REDCLIFFE 4020


Ph: (07) 32841466
Email mail@wdsurveys.com.au



SCENIC RIM REGIONAL COUNCIL

**STAGES 1A & 1B 22A TELEMON STREET, BEAUDESERT
ROADWORK AND DRAINAGE - OVERALL PLAN**

SCALE	1:500
SHEET	1 OF 5 SHEETS
DRAWING NO.	
AC14546SW-0	

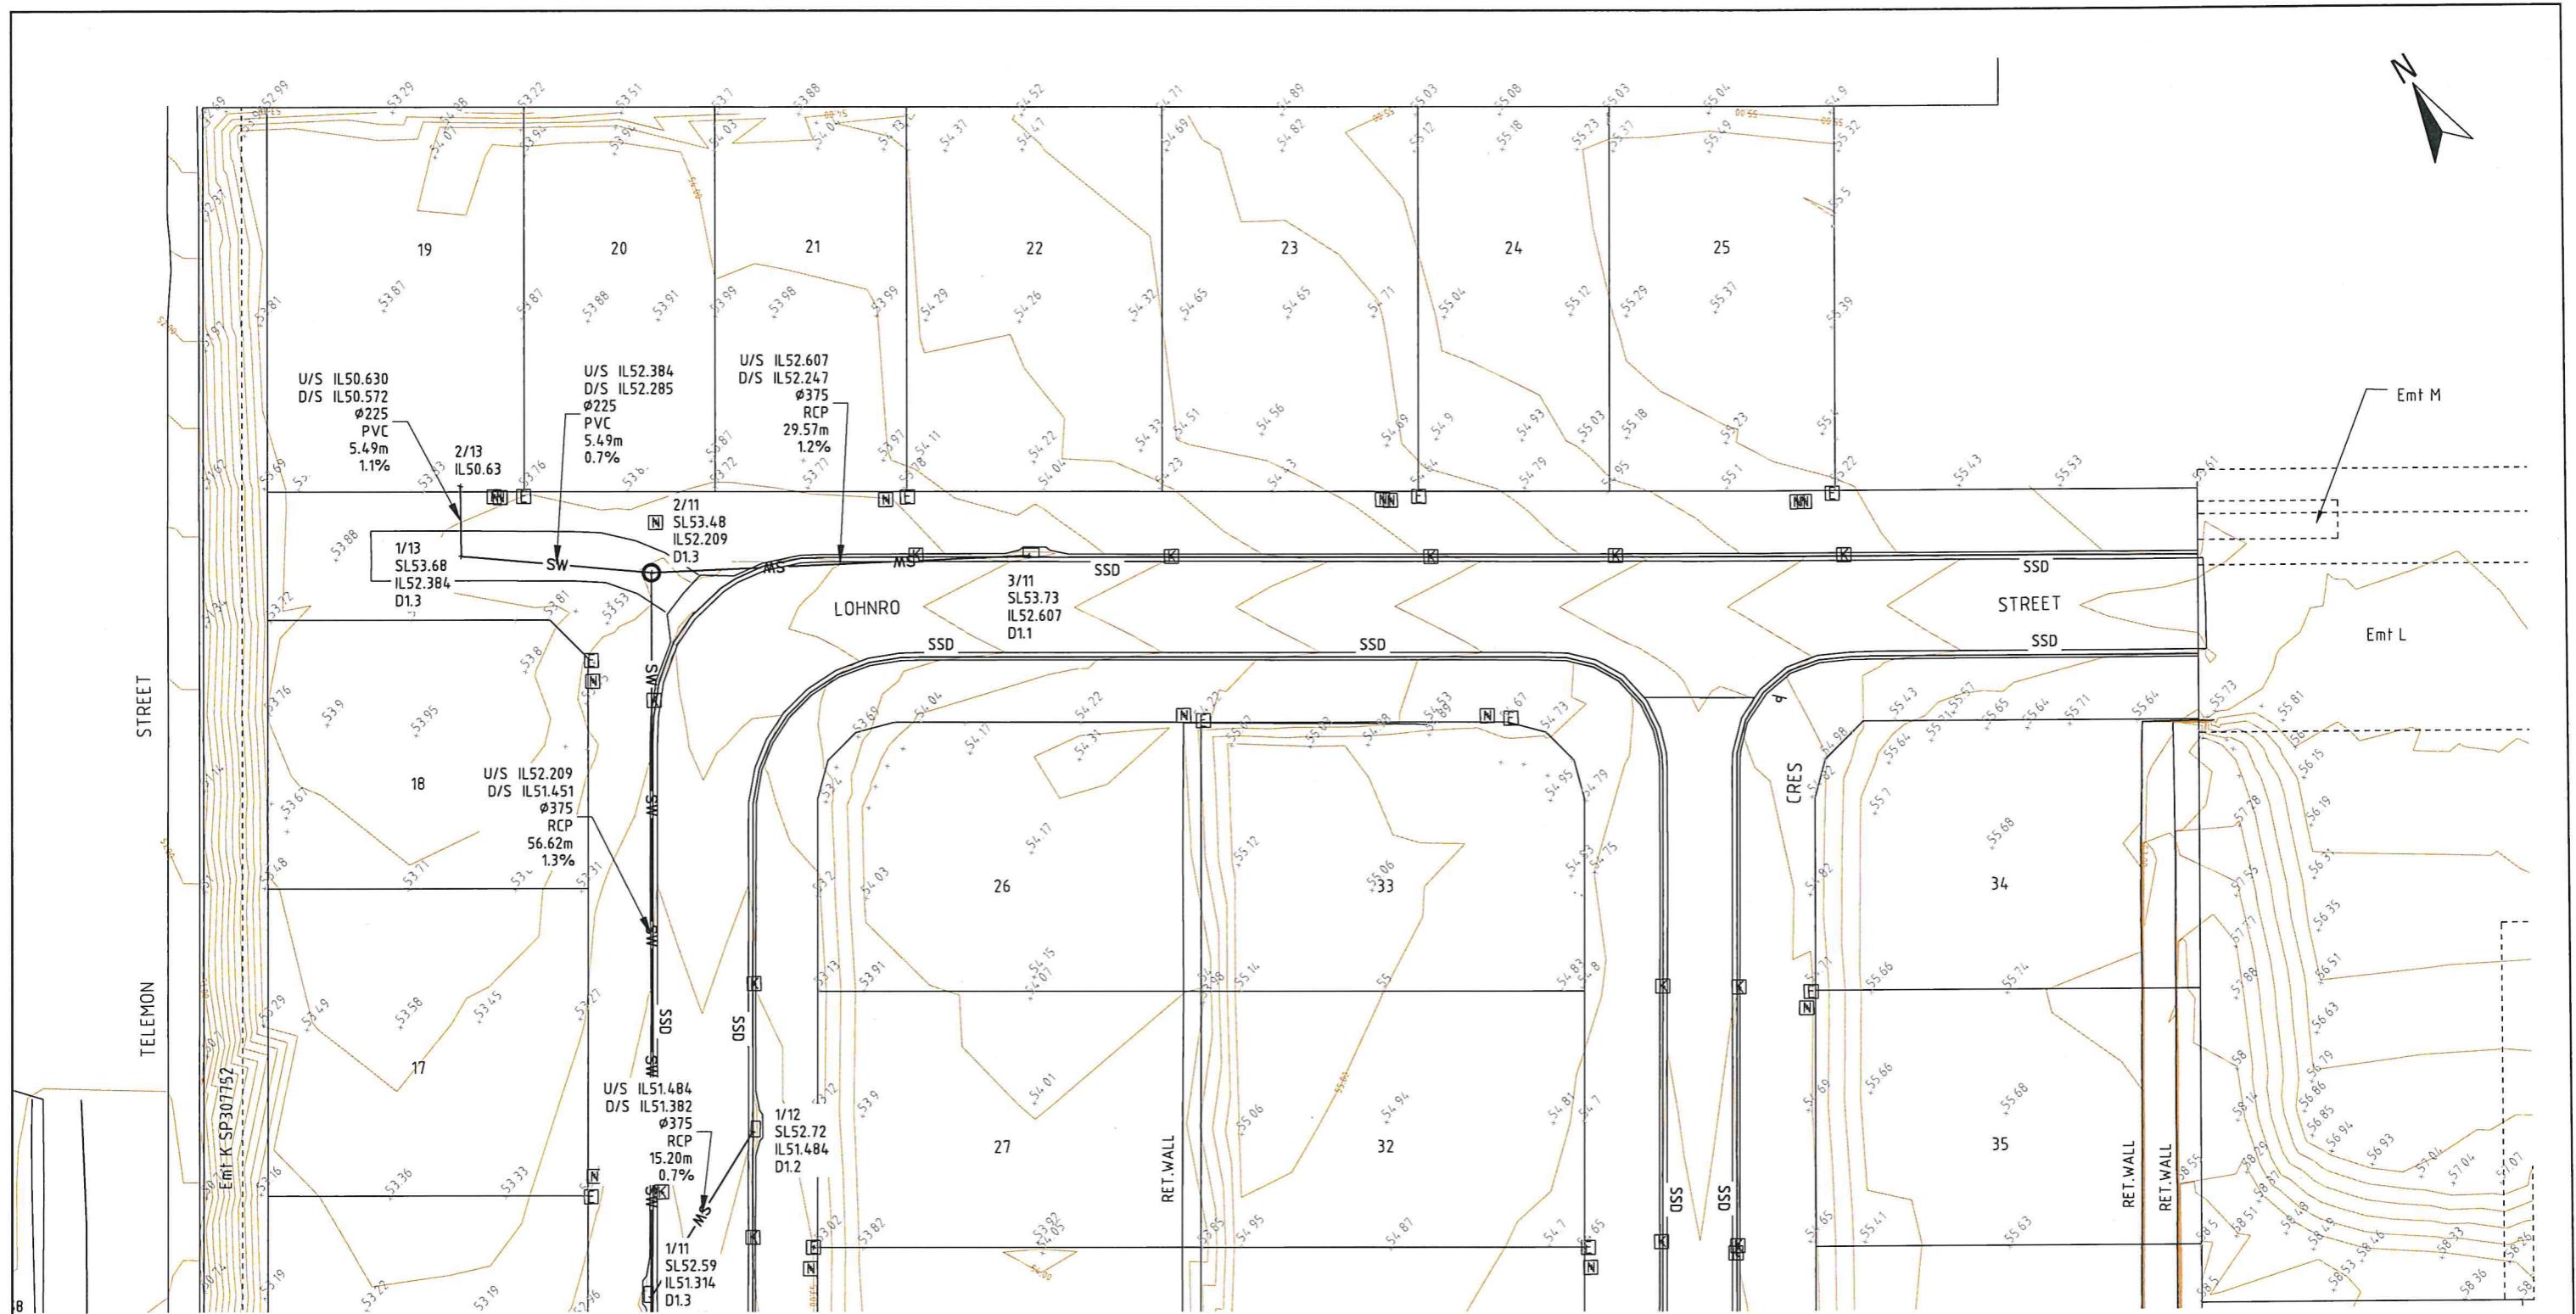

ENGINEER'S CERTIFICATION

- I, [Signature], hereby certify that:
- The information contained in this drawing / document is in compliance with approved drawings and design.
 - The new water and sewerage works defined by this drawing have been designed and constructed in accordance with the SEQ Code.
 - This represents an accurate record of as-constructed works.
 - I accept responsibility for the information contained in this drawing / document.

RPEQ (signature) RPEQ No. _____ Date: _____

REGISTERED SURVEYOR'S CERTIFICATION

I, Evol Joseph Deller, hereby certify that the vertical and horizontal locations and dimensions shown on this plan are a true and correct record and were located by survey.

Registered Surveyor (sig.) Reg. Surveyor No. S 2205 Date: 2.11.2020

LEGEND


- Elect. manhole
- Elect. box
- NBN pit
- Elect. pole
- ▲ Sign
- ☒ Kerb outlet
- ☒ SSD Subsoil drain

AS CONSTRUCTED

0 5 10 15 20
1:250
ALL DISTANCES IN METRES

A1								
0	2-11-2020	ORIGINAL ISSUE						
INDEX DATE		REVISIONS	PGC	DRAWN	CHECKED	PASSED	INITIALS	DATE

DRAWN	PGC	2-11-2020
CHECKED		
PASSED		

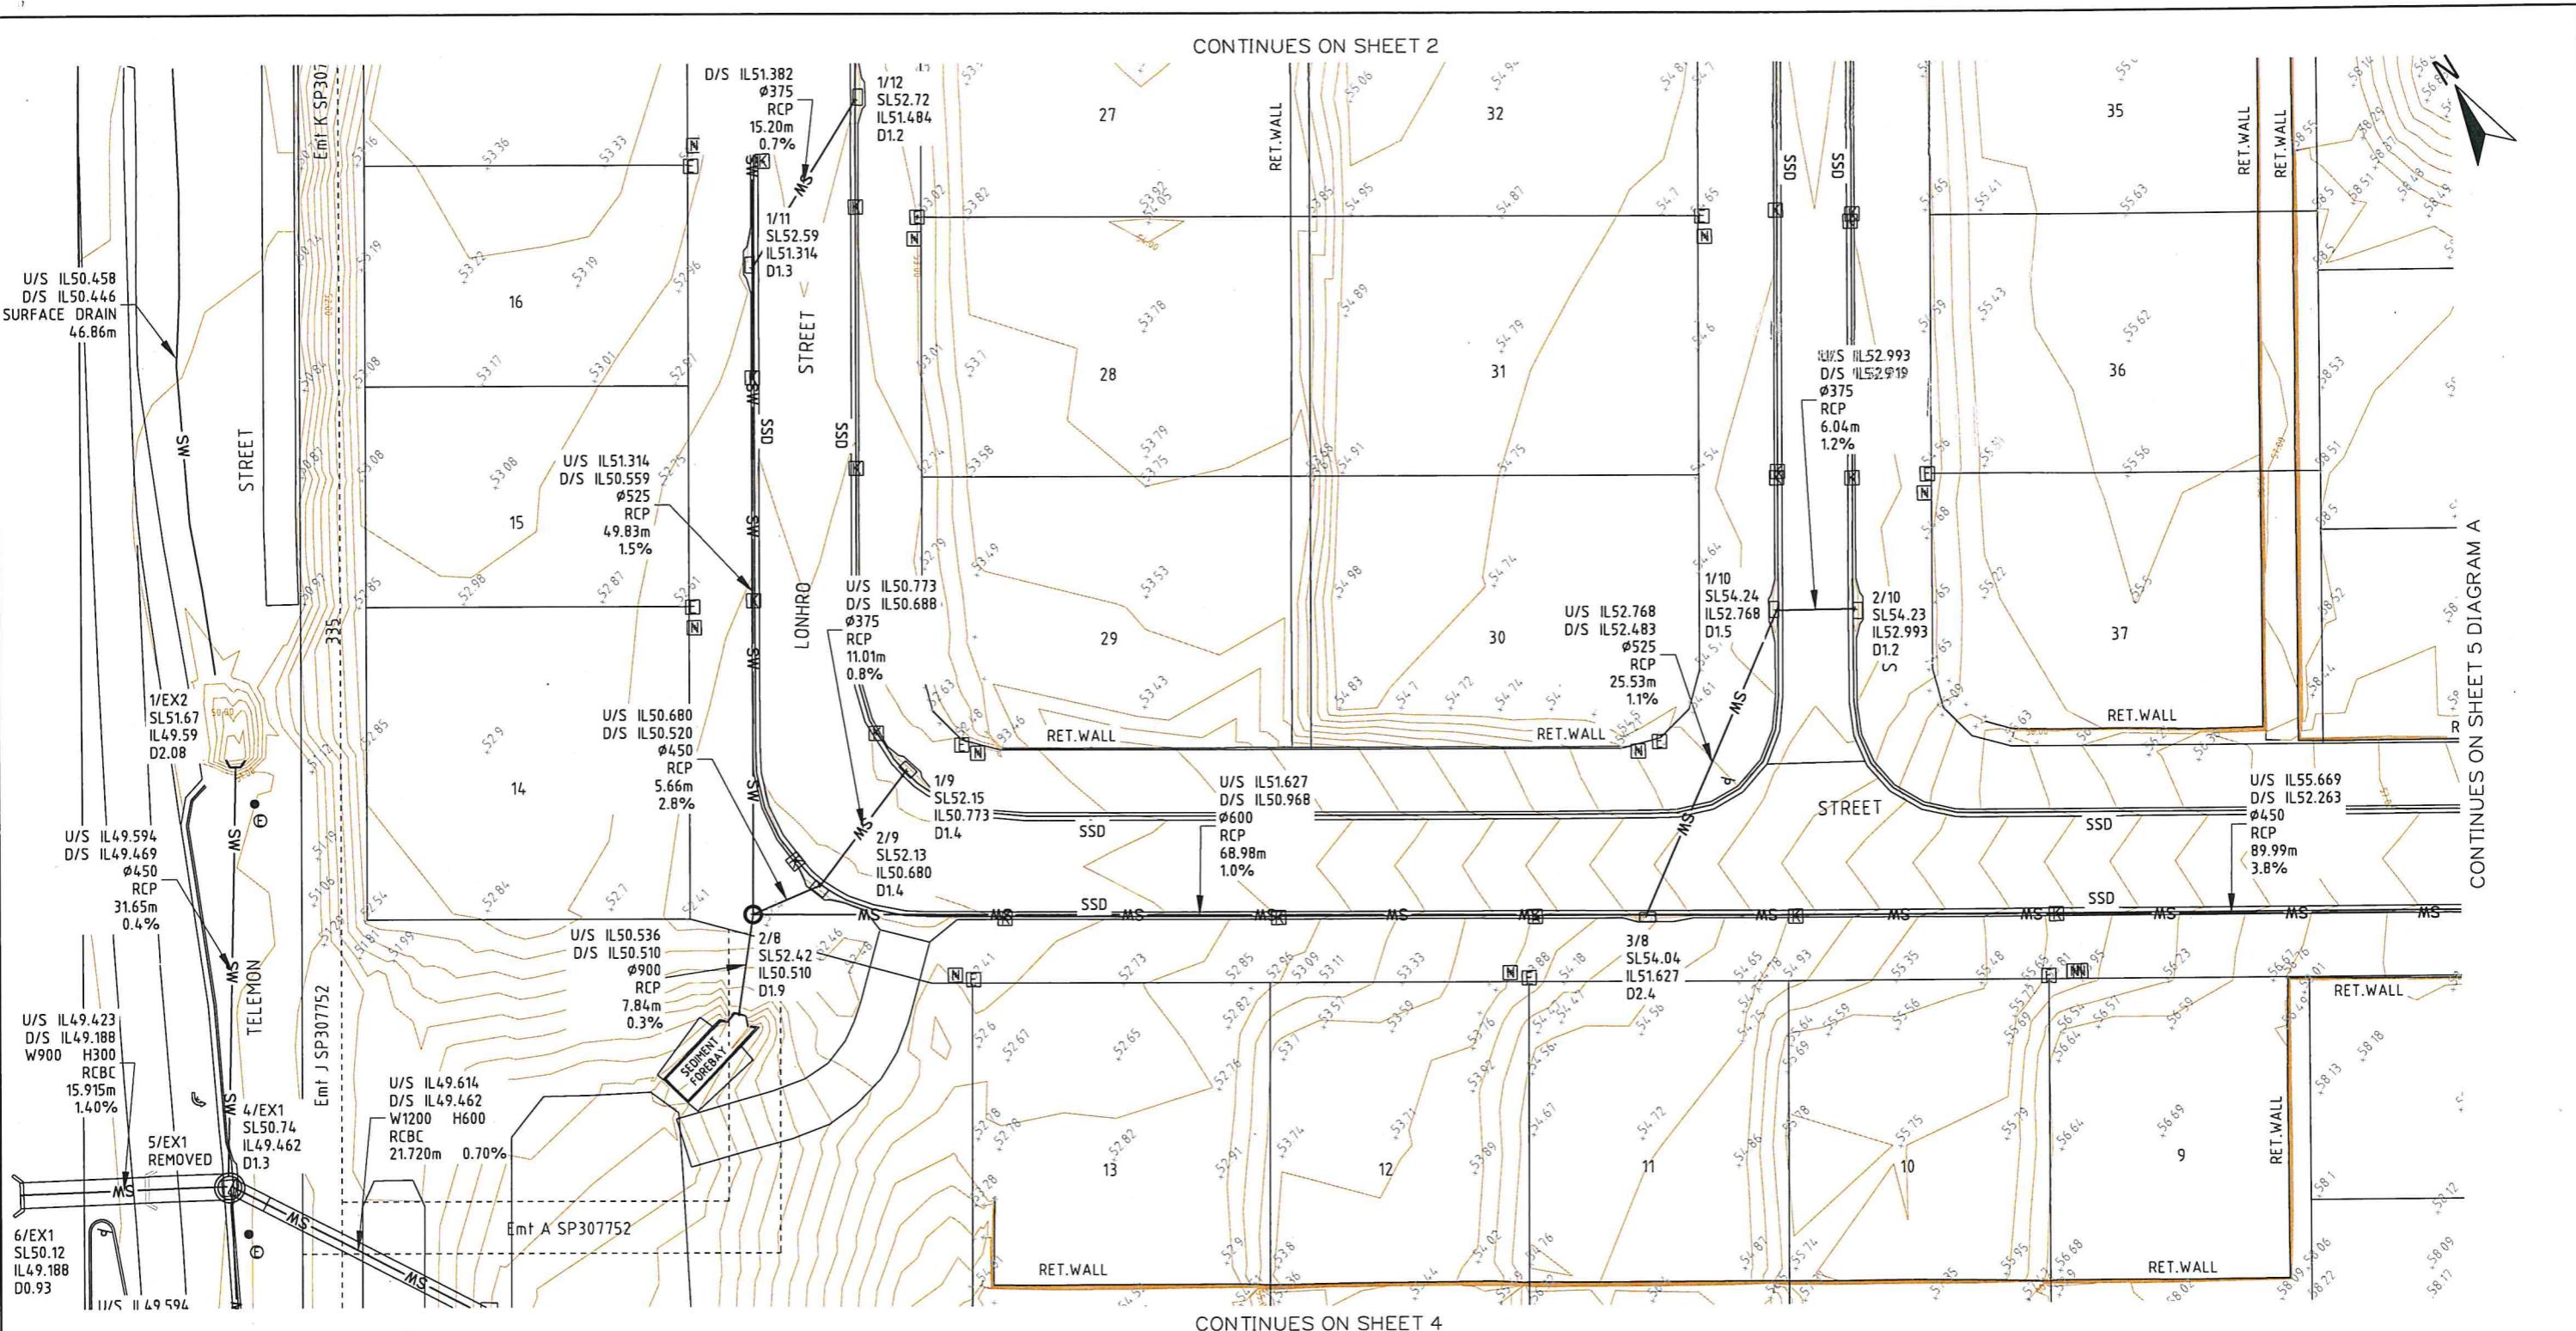

ENGINEER'S CERTIFICATION

- I, hereby certify that:
- The information contained in this drawing / document is in compliance with approved drawings and design.
 - The new water and sewerage works defined by this drawing have been designed and constructed in accordance with the SEQ Code.
 - This represents an accurate record of as-constructed works
 - I accept responsibility for the information contained in this drawing / document.

RPEQ (signature) RPEQ No. _____ Date: _____

REGISTERED SURVEYOR'S CERTIFICATION


- I, Errol Joseph Deller, hereby certify that the vertical and horizontal locations and dimensions shown on this plan are a true and correct record and were located by survey.

Errol Joseph Deller
Registered Surveyor (sig) Reg. Surveyor No. S2205 Date: 2.11.2020

LEGEND

- Elect. manhole
- Elect. box
- NBN pit
- Elect. pole
- △ Sign
- K Kerb outlet
- SSD Subsoil drain

AS CONSTRUCTED

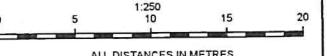


ALL DISTANCES IN METRES

A1

0	2-11-2020	ORIGINAL ISSUE	
INDEX	DATE	REVISIONS	
		DRAWN CHECKED PASSED	

DRAWN	PGC	2-11-2020
CHECKED		
PASSED		
INITIALS	DATE	

CONTINUES ON SHEET 3

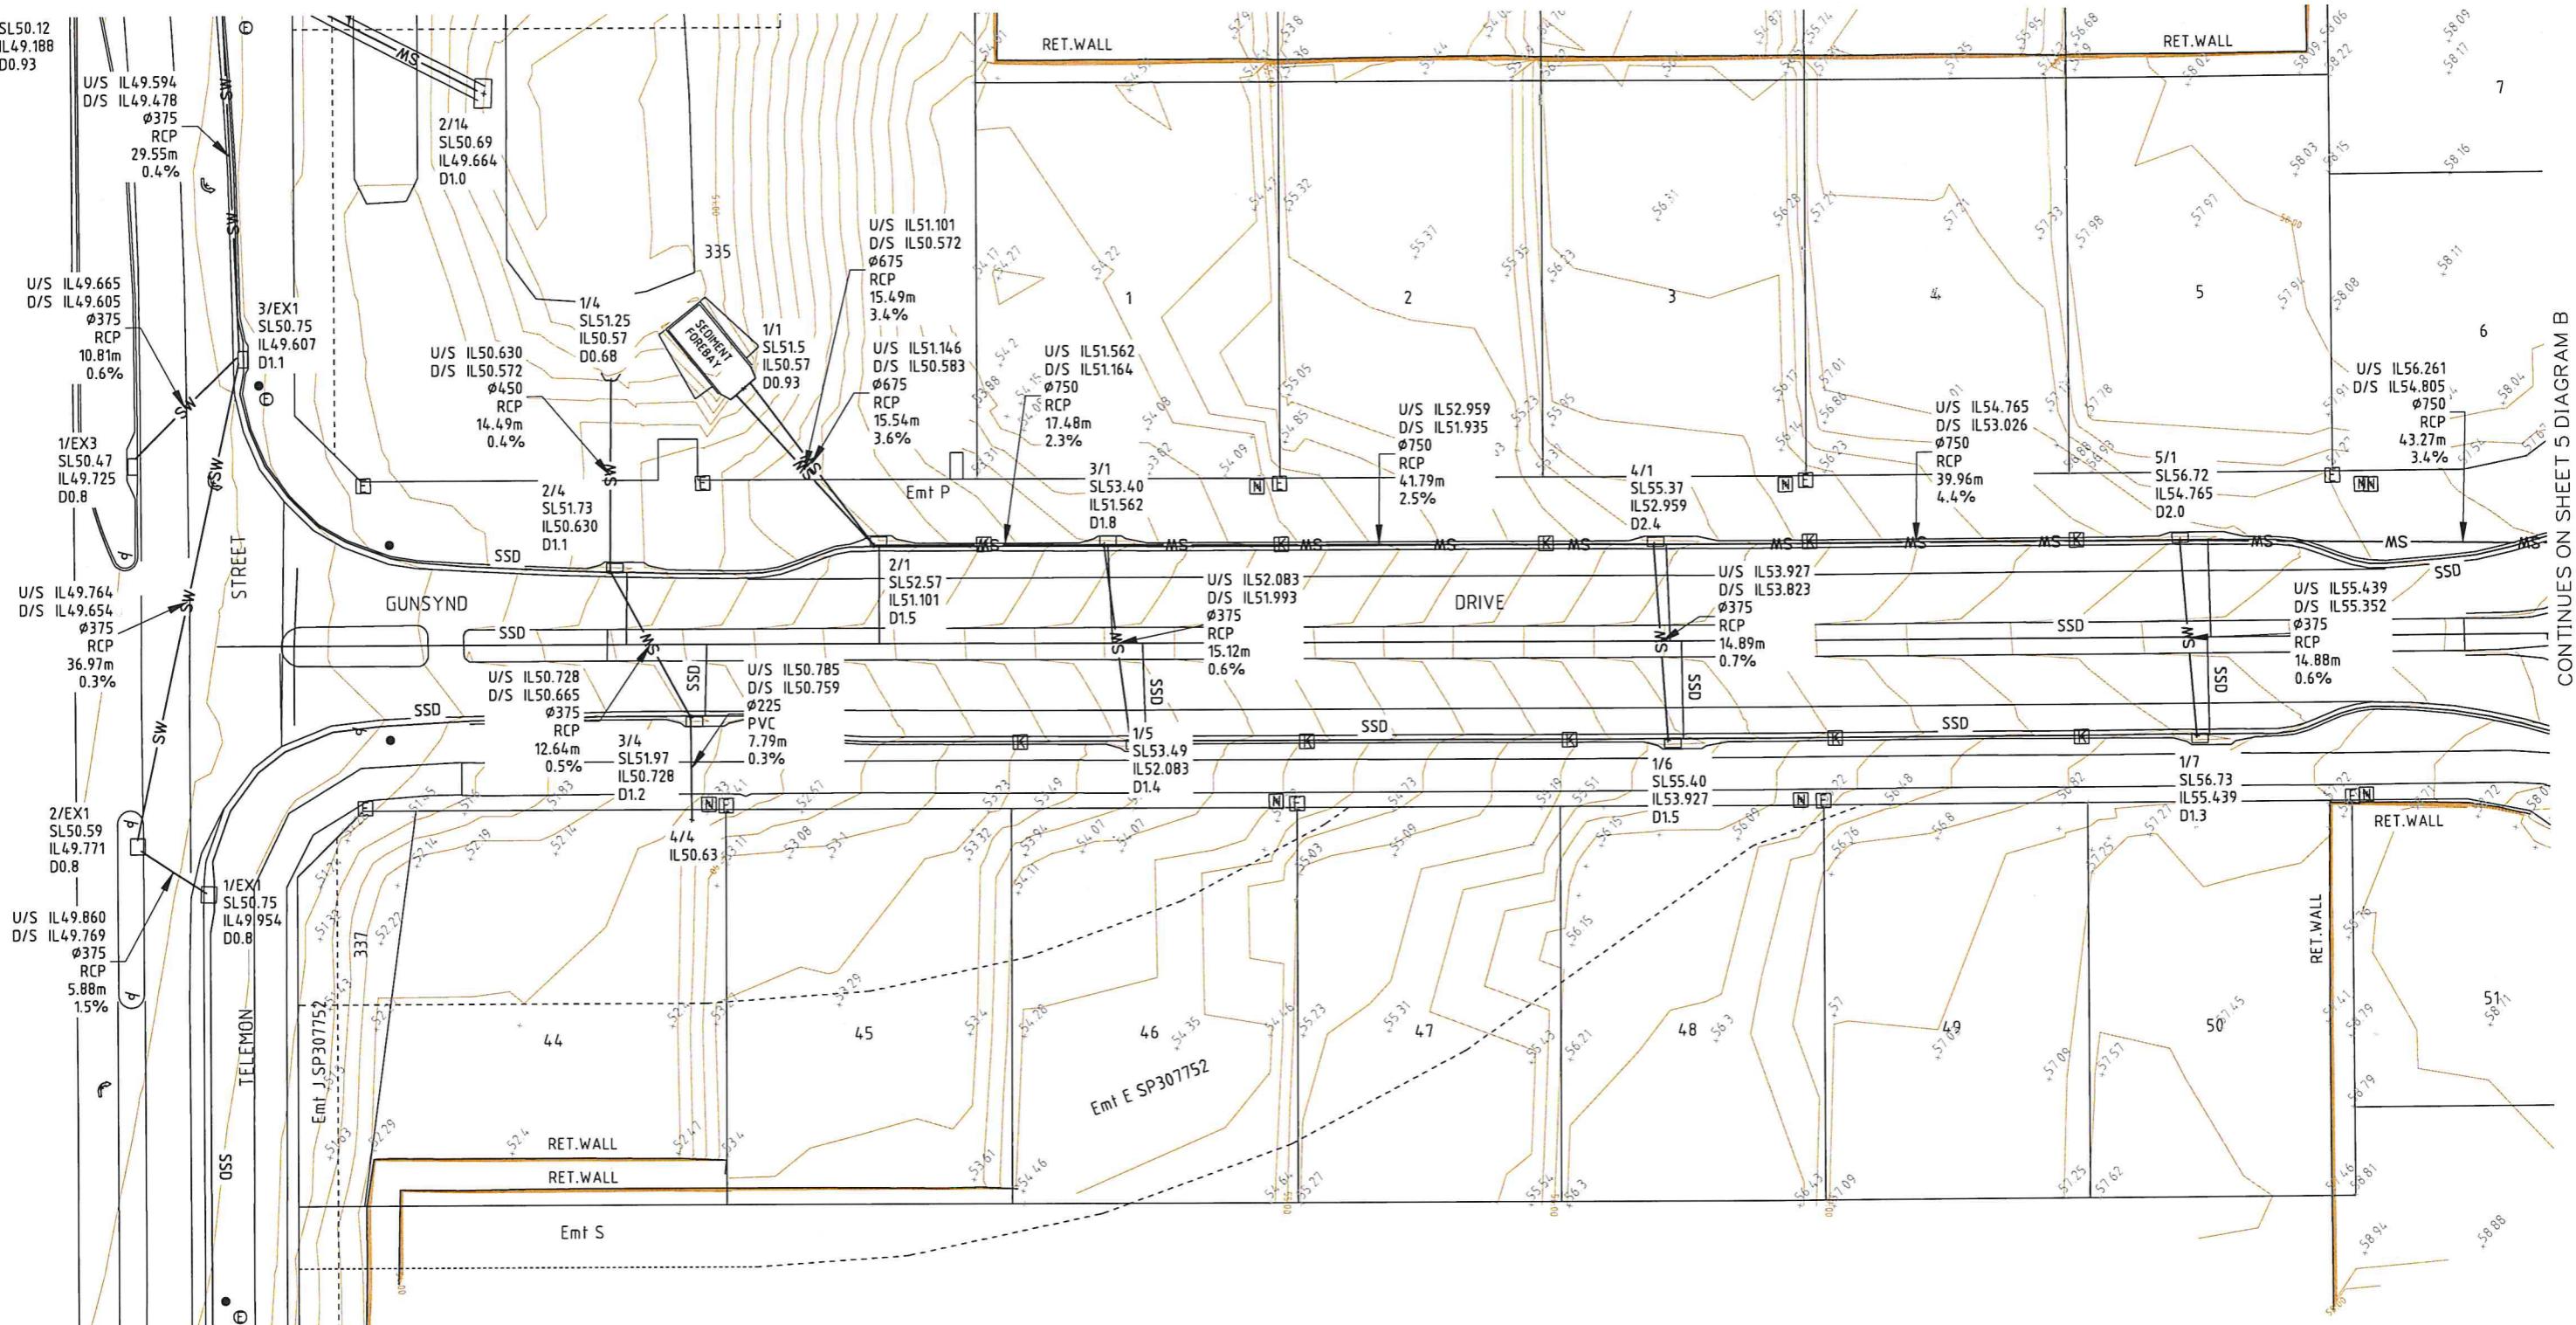

CONTINUES ON SHEET 5 DIAGRAM B

ENGINEER'S CERTIFICATION

- I, hereby certify that:
1. The information contained in this drawing / document is in compliance with approved drawings and design.
 2. The new water and sewerage works defined by this drawing have been designed and constructed in accordance with the SEQ Code.
 3. This represents an accurate record of as-constructed works.
 4. I accept responsibility for the information contained in this drawing / document.

RPEQ (signature) RPEQ No. _____ Date: _____

REGISTERED SURVEYOR'S CERTIFICATION

I, Erol Joseph Deller, hereby certify that the vertical and horizontal locations and dimensions shown on this plan are a true and correct record and were located by survey.

Erol Joseph Deller

Registered Surveyor (sig.) Reg. Surveyor No. S2205 Date: 2.11.2020

LEGEND

- Ⓐ Elect. manhole
- Ⓑ Elect. box
- Ⓝ NBN pit
- Elect. pole
- Ⓐ Sign
- Ⓚ Kerb outlet
- SSD Subsoil drain

AS CONSTRUCTED

0 5 10 15 20

ALL DISTANCES IN METRES

A1

0	2-11-2020	ORIGINAL ISSUE	PDC	
INDEX	DATE	REVISIONS	DRAWN	CHECKED

WD Surveys					LICENSED SURVEYORS and DEVELOPMENT CONSULTANTS	SCENIC RIM REGIONAL COUNCIL	SCALE 1:250
15 ANZAC AVE REDCLIFFE 4020 P.O.Box 548 REDCLIFFE 4020					Ph: (07) 32841468 Email: mail@wdsurveys.com.au	SCENIC RIM Regional Council	SHEET 4 OF 5 SHEETS
DRAWN PDC 2-11-2020 CHECKED PASSED INITIALS DATE						STAGES 1A & 1B 22A TELEMON STREET, BEAUDESERT ROADWORK AND DRAINAGE - OVERALL PLAN	DRAWING NO. AC14546SW-0

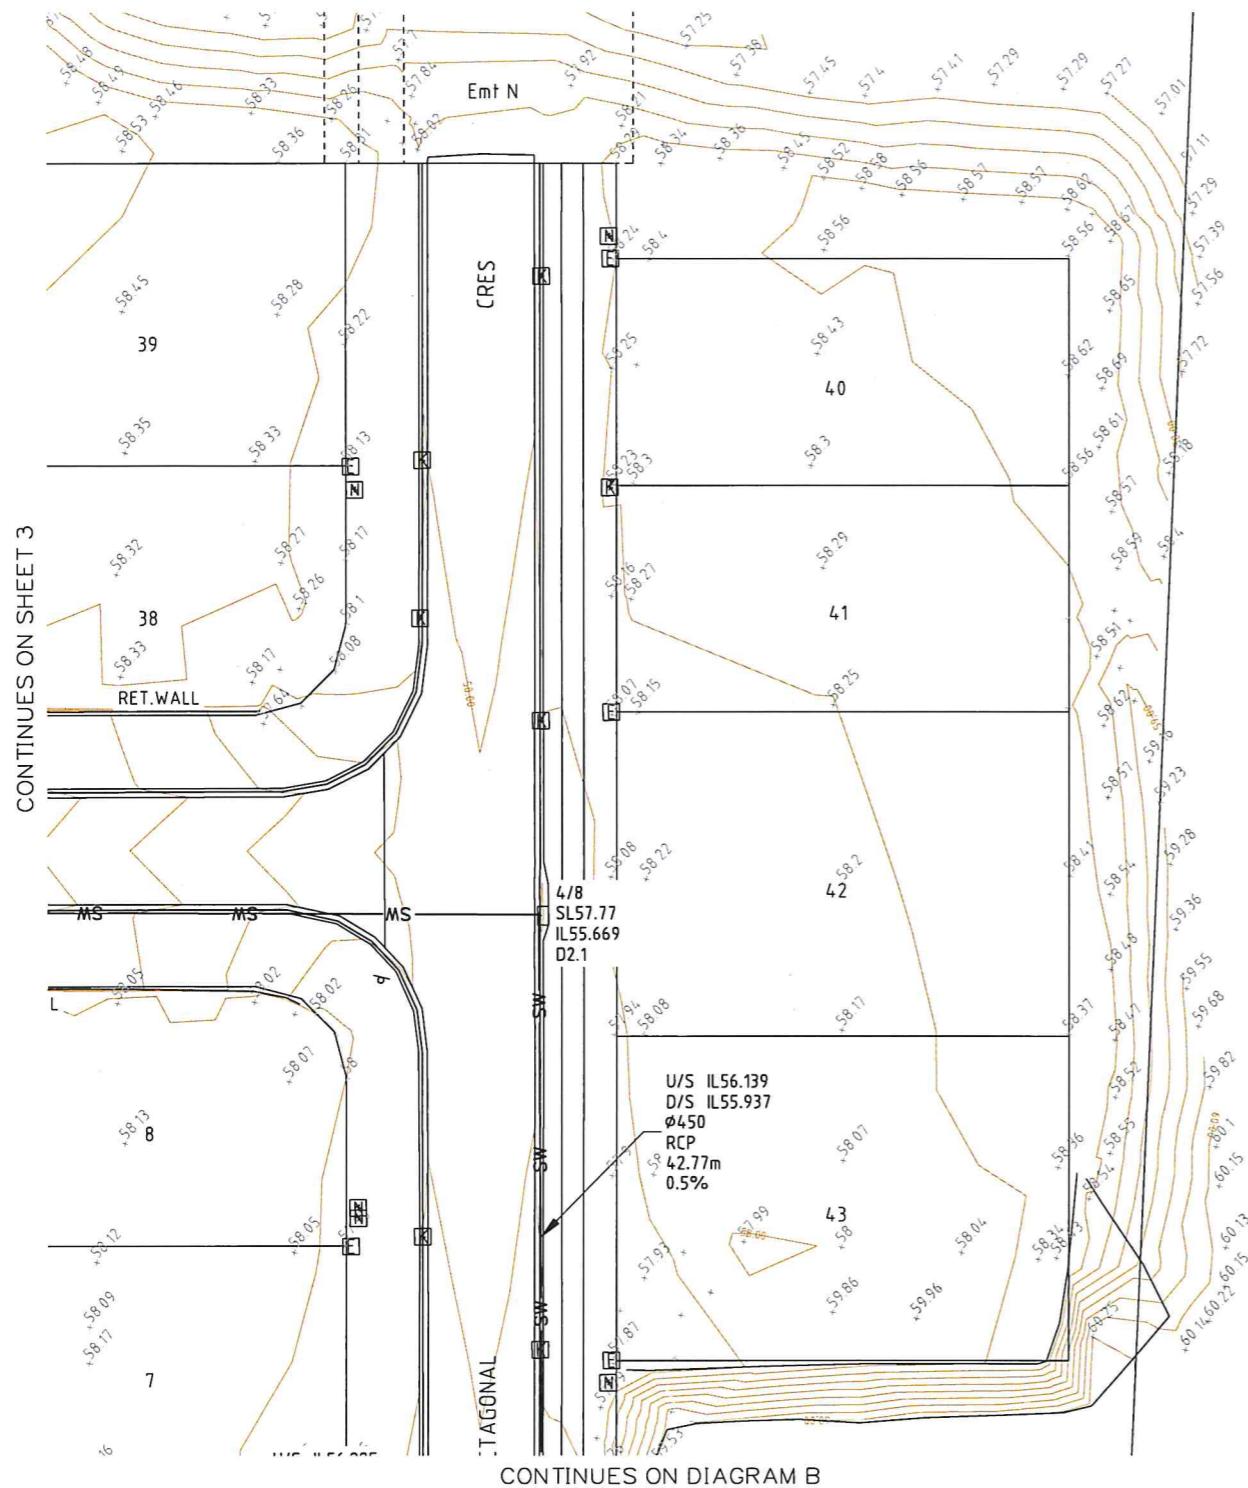


DIAGRAM A

ENGINEER'S CERTIFICATION

- I,, hereby certify that:

 1. The information contained in this drawing / document is in compliance with approved drawings and design.
 2. The new wafer and sewerage works defined by this drawing have been designed and constructed in accordance with the SEQ Code.
 3. This represents an accurate record of as-constructed works
 4. I accept responsibility for the information contained in this drawing / document.

RPEQ (signature) RPEQ No. _____ Date: _____

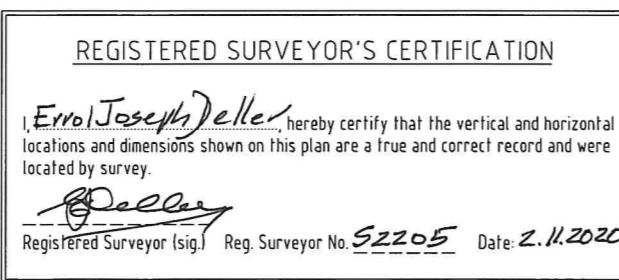


DIAGRAM B


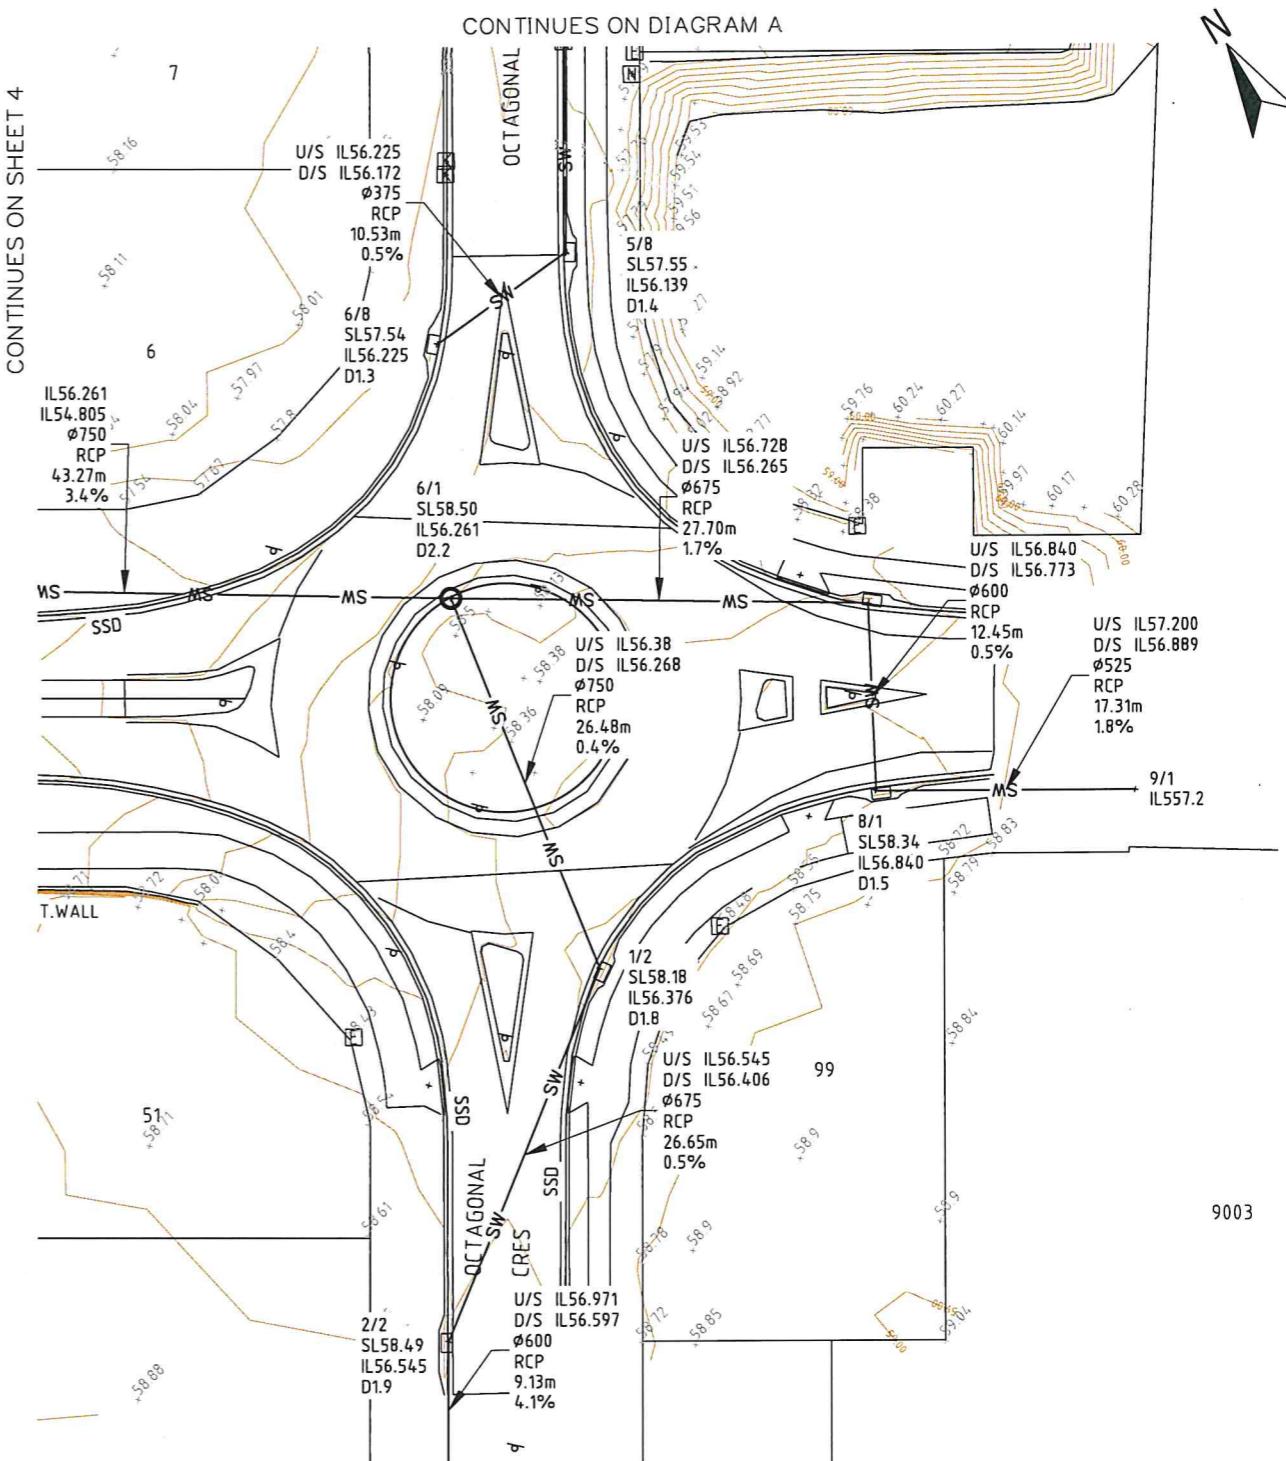


DIAGRAM B

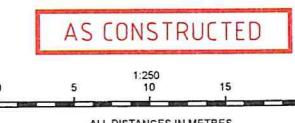

A1

0	Z-11-2020	ORIGINAL ISSUE
INDEX	DATE	REVISIONS

DRAWN	PGC	2-11-2020
CHECKED		
PASSED		
	INITIALS	DATE

V
IS AN
REDO
P.O.B.
REDO

LICENSED SURVEYORS and
DEVELOPMENT CONSULTANTS

WD Surveys

IS ANZAC AVE
REDCLIFFE 4020
P.O.Box 548
REDCLIFFE 4020

Ph: (07) 32841466
Email mail@wdsurveys.com.au



SCENIC RIM REGIONAL COUNCIL

STAGES 1A & 1B 22A TELEMON STREET, BEAUDESERT ROADWORK AND DRAINAGE - OVERALL PLAN

SCALE	1:250
SHEET 5 OF	5 SHEETS
DRAWING NO.	
AC14546SW-0	